


15-039-20326-00-00

STATE OF KANSAS
STATE CORPORATION COMMISSION
CONSERVATION DIVISION
P. O. BOX 17027
WICHITA, KANSAS 67217

FORM CP-4

WELL PLUGGING RECORD

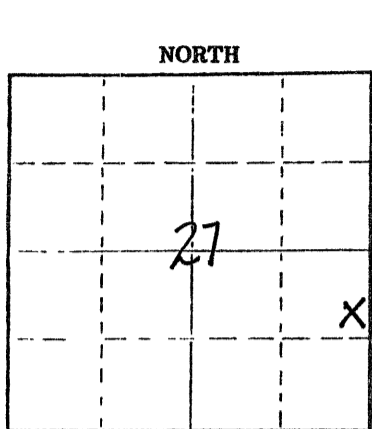

Locate well correctly on above Section Plat

Decatur County, Sec. 27 Twp. 4S Rge. ~~27~~ 27 (W)

Location as "NE/CNW/SW" or footage from lines SE NE SE

Lease Owner John P. Jennings

Lease Name TACHA Well No. #1

Office Address Suite 309 200 E. First Street, Wichita, Ks. 67202

Character of Well (completed as Oil, Gas or Dry Hole) Dry Hole

Date well completed April 16, 19 76

Application for plugging filed (verbally) April 16, 19 76

Application for plugging approved (verbally) April 16, 19 76

Plugging commenced April 16, 19 76

Plugging completed April 16, 19 76

Reason for abandonment of well or producing formation No commercial quantity of oil or gas encountered.

If a producing well is abandoned, date of last production 19

Was permission obtained from the Conservation Division or its agents before plugging was commenced? Yes

Name of Conservation Agent who supervised plugging of this well Leo Massey

Producing formation Depth to top Bottom Total Depth of Well 3715'

Show depth and thickness of all water, oil and gas formations.

OIL, GAS OR WATER RECORDS

CASING RECORD

FORMATION	CONTENT	FROM	TO	SIZE	PUT IN	PULLED OUT
				8 5/8"	237.61'	none

Describe in detail the manner in which the well was plugged, indicating where the mud fluid was placed and the method or methods used in introducing it into the hole. If cement or other plugs were used, state the character of same and depth placed, from feet to feet for each plug set.

1st Plug was Set @ 1550' with 70 sx. cement

2nd Plug was Set @ 215' with 20 sx. cement

3rd Plug was Set @ 40' with 10 sx. cement

(If additional description is necessary, use BACK of this sheet)

Name of Plugging Contractor Abercrombie Drilling, Inc.

Address 801 Union Center Wichita, Kansas 67202

STATE OF KANSAS COUNTY OF SEDGWICK ss.

Jerry A. Langrehr-Exec. Vice President (employee of owner) or (owner or operator) of the above-described

well, being first duly sworn on oath, says: That I have knowledge of the facts, statements, and matters herein contained and the log of the above-described well as filed and that the same are true and correct. So help me God.

(Signature) Jerry A. Langrehr

801 Union Center, Wichita, Kansas 67202

(Address)


SUBSCRIBED AND SWORN TO before me this 22nd day of April, 19 76

Diane Steincamp

My commission expires February 18, 1980

Diane Steincamp

Notary Public.

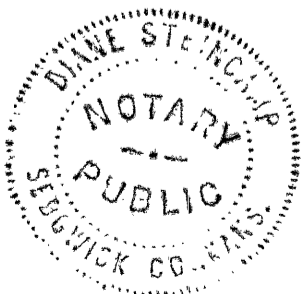

RECEIVED
STATE CORPORATION COMMISSION

APR 27 1976 427-76

CONSERVATION DIVISION
Wichita, Kansas