

15-039-30068-00-00

STATE OF KANSAS
STATE CORPORATION COMMISSION

Form CP-4


WELL PLUGGING RECORD

Give All Information Completely
Make Required Affidavit
Mail or Deliver Report to:
Conservation Division
State Corporation Commission
211 No. Broadway
Wichita, Kansas

Decatur County, Sec. 35 Twp. 4S Rge. (E) 27 (W)

Location as "NE/CNW/SW" or footage from lines. SE SE SE
Lease Owner Chief Drilling Co., Inc.
Lease Name McKENNA Well No. 1
Office Address Box 797 - Great Bend, Kansas
Character of Well (completed as Oil, Gas or Dry Hole) Dry Hole
Date well completed 7/17 1966
Application for plugging filed 7/17 1966
Application for plugging approved 7/17 1966
Plugging commenced 7/17 1966
Plugging completed 7/17 1966
Reason for abandonment of well or producing formation Dry Hole

NORTH

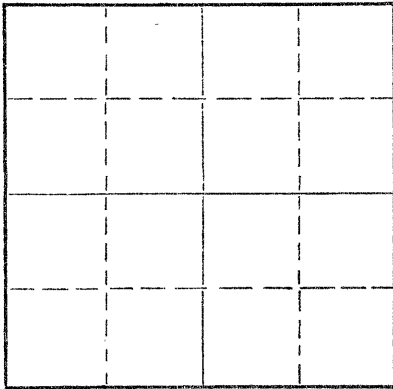

Locate well correctly on above
Section Plat

If a producing well is abandoned, date of last production _____ 19____
Was permission obtained from the Conservation Division or its agents before plugging was commenced? Yes

Name of Conservation Agent who supervised plugging of this well Bill Nicholson - Morland, Kansas
Producing formation _____ Depth to top _____ Bottom _____ Total Depth of Well 3755 Feet
Show depth and thickness of all water, oil and gas formations.

OIL, GAS OR WATER RECORDS

CASING RECORD

FORMATION	CONTENT	FROM	TO	SIZE	PUT IN	PULLED OUT
		0	204	8-5/8"	204	None

Describe in detail the manner in which the well was plugged, indicating where the mud fluid was placed and the method or methods used in introducing it into the hole. If cement or other plugs were used, state the character of same and depth placed, from _____ feet to _____ feet for each plug set.

Wooden plug set @ 600'
Mixed 25 sacks cement through drill pipe
Hulls and wooden plug set @ 210'
Mixed 25 sacks cement through drill pipe
Hulls & wooden plug set @ 240'

RECEIVED
STATE CORPORATION COMMISSION
JUL 20 1966
CONSERVATION DIVISION
WICHITA, KANSAS

7-20-66

(If additional description is necessary, use BACK of this sheet)
Name of Plugging Contractor Chief Drilling Co., Inc.
Address Box 797 - Great Bend, Kansas

STATE OF KANSAS, COUNTY OF BARTON, ss.
V. Richard Hoover, President (employee of owner) or (owner or operator) of the above-described well, being first duly sworn on oath, says: That I have knowledge of the facts, statements, and matters herein contained and the log of the above-described well as filed and that the same are true and correct. So help me God. CHIEF DRILLING CO., INC.
(Signature) [Signature]
Box 797 - Great Bend, Kansas (Address)

SUBSCRIBED AND SWORN TO before me this 18th day of July, 19 66

My commission expires Jan. 26, 1967
Carmen R. Cook
Carmen R. Cook, Notary Public.