


Give All Information Completely  
Make Required Affidavit  
Mail or Deliver Report to:  
Conservation Division  
State Corporation Commission  
212 No. Market  
Wichita, Kansas

15-039-20248-00-00

WELL PLUGGING RECORD

NORTH

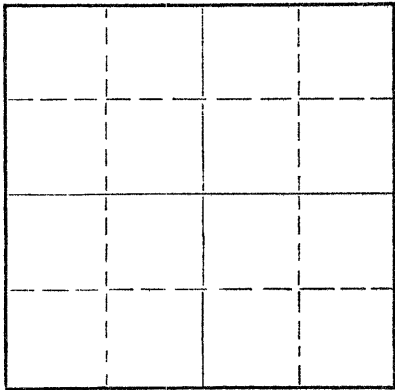

Locate well correctly on above  
Section Plat

Decatur County. Sec. 35 Twp. 4S Rge. 27 (W)  
Location as "NE/CNW/SW" or footage from lines C N/2 NE SE  
Lease Owner Edmiston Oil Company  
Lease Name BAILEY Well No. 1  
Office Address 801 First Natl Bank Bldg., Wichita, Ks. 67202  
Character of Well (completed as Oil, Gas or Dry Hole) dry hole  
Date well completed November 18, 1972  
Application for plugging filed December 1, 1972  
Application for plugging approved November 20, 1972  
Plugging commenced November 18, 1972  
Plugging completed November 18, 1972  
Reason for abandonment of well or producing formation dry hole

If a producing well is abandoned, date of last production 19  
Was permission obtained from the Conservation Division or its agents before plugging was commenced? yes

Name of Conservation Agent who supervised plugging of this well W. L. Nichols, Box 157, Morland, Kansas  
Producing formation Depth to top Bottom Total Depth of Well 3708 Feet  
Show depth and thickness of all water, oil and gas formations.

OIL, GAS OR WATER RECORDS

CASING RECORD

FORMATION	CONTENT	FROM	TO	SIZE	PUT IN	PULLED OUT
Surface Pipe		-0-	244'	8-5/8"	11/6/72	none

Describe in detail the manner in which the well was plugged, indicating where the mud fluid was placed and the method or methods used in introducing it into the hole. If cement or other plugs were used, state the character of same and depth placed, from feet to feet for each plug set.

Set bottom plug @ 1300' w/20 sacks cement;  
Set middle plug @ 275' w/20 sacks cement;  
Set top plug @ 40' w/10 sacks cement.

RECEIVED  
STATE CORPORATION COMMISSION  
DEC 4 - 1972  
CONSERVATION DIVISION  
Wichita, Kansas


12-4-72

(If additional description is necessary, use BACK of this sheet)  
Name of Plugging Contractor E. K. Edmiston Drilling Co., Inc.  
Address 801 First Natl Bank Bldg., Wichita, Kansas 67202

STATE OF KANSAS, COUNTY OF SEDGWICK, ss.  
Robt. K. Edmiston (employee of owner) of the above-described well, being first duly sworn on oath, says: That I have knowledge of the facts, statements, and matters herein contained and the log of the above-described well as filed and that the same are true and correct. So help me God.

(Signature) Robt. K. Edmiston

December 1, 1972  
(Address)

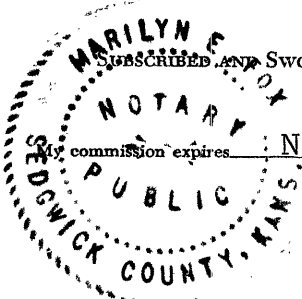

Subscribed and Sworn to before me this 1st day of December, 1972

My commission expires November 9, 1973

Marilyn E. Fox  
Notary Public.