

15-137-20228-00-00

STATE OF KANSAS  
STATE CORPORATION COMMISSION

WELL PLUGGING RECORD

Give All Information Completely  
Make Required Affidavit  
Mail or Deliver Report to  
Conservation Division  
State Corporation Comm.  
245 North Water  
Wichita, KS 67202


Norton County, Sec. 20 Twp. 4S Rge. 24 /E/  
Location as "NE/CNW $\frac{1}{4}$ SW $\frac{1}{4}$ " or footage from lines  
SW SW SW

Lease Owner Norco Petroleum  
Lease Name K. G. Heikes Well No. 1  
Office Address 11208 N. 84th St., Scottsdale, Arizona  
Character of Well (Completed as Oil, Gas or Dry Hole) 85260  
Dry Hole

Date Well completed 8-2-1981  
Application for plugging filed 8-2-1981  
Application for plugging approved 8-2-1981  
Plugging commenced 8-2-1981  
Plugging completed 8-2-1981  
Reason for abandonment of well or producing formation Dry Hole

If a producing well is abandoned, date of last production 19

Was permission obtained from the Conservation Division or its agents before plugging was commenced? yes

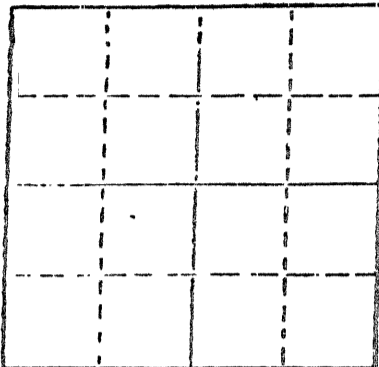

Locate well correctly on above Section Plot

Name of Conservation Agent who supervised plugging of this well \_\_\_\_\_  
Producing formation \_\_\_\_\_ Depth to top \_\_\_\_\_ Bottom \_\_\_\_\_ Total Depth of Well \_\_\_\_\_  
Show depth and thickness of all water, oil and gas formations.

OIL, GAS OR WATER RECORDS

CASING RECORD

FORMATION	CONTENT	FROM	TO	SIZE	PUT IN	PULLED OUT
				8-5/8"	231'	-0-

Describe in detail the manner in which the well was plugged, indicating where the mud fluid was placed and the method or methods used in introducing it into the hold. If cement or other plugs were used, state the character of same and depth placed, from \_\_\_\_\_ feet to \_\_\_\_\_ feet for each plug set.

Mud laden 4013' - 1100'  
60 sks cement @ 1100'  
20 sks cement 240'  
10 sks cement 40'  
5 sks cement in rat hole.

RECEIVED  
STATE CORPORATION COMMISSION  
08-05-1981  
AUG 5 1981

CONSERVATION DIVISION  
Wichita, Kansas

(If additional description is necessary, use BACK of this sheet.)  
Name of Plugging Contractor Emphasis Oil Operations

STATE OF KANSAS COUNTY OF RUSSELL, ss.  
Joe K. Branum (employee of owner) or (owner or operator)  
of the above-described well, being first duly sworn on oath, says: That I have knowledge of the facts, statements, and matters herein contained and the log of the above-described well as filed and that the same are true and correct. So help me God.

(Signature) [Signature]  
P. O. Box 506, Russell, KS 67665  
(Address)

SUBSCRIBED AND SWORN TO before me this 4th day of August, 1981.

My commission expires February 6, 1984.

Glenda R. Tiffin  
Glenda R. Tiffin Notary Public.

