

WELL PLUGGING RECORD

15-137-00738-00-00

Give All Information Completely
Make Required Affidavit
Mail or Deliver Report to:
Conservation Division
State Corporation Commission
211 No. Broadway
Wichita, Kansas

Norton County, Sec. 2 Twp. 4 Rge. (E) 24(W)

Location as "NE/CNW/SW" or footage from lines CNL NW

Lease Owner Theodore Gore

Lease Name Henry Well No. 4

Office Address 650 Fourth Nat'l Bank Bldg., Wichita, Kansas

Character of Well (completed as Oil, Gas or Dry Hole) Oil

Date well completed April 1955

Application for plugging filed March 1972

Application for plugging approved April 5, 1972


Plugging commenced May 17, 1972

Plugging completed May 19, 1972

Reason for abandonment of well or producing formation Well not profitable

If a producing well is abandoned, date of last production March 20, 1972

Was permission obtained from the Conservation Division or its agents before plugging was commenced? yes

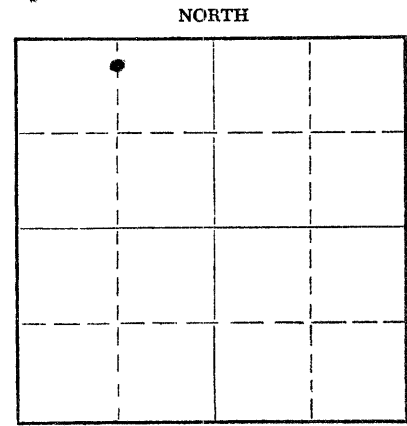

Locate well correctly on above Section Plat

Name of Conservation Agent who supervised plugging of this well W. L. Nichols
Producing formation Arbuckle Depth to top 3758' Bottom Total Depth of Well 3764 Feet

Show depth and thickness of all water, oil and gas formations.

OIL, GAS OR WATER RECORDS

CASING RECORD

Table with 7 columns: FORMATION, CONTENT, FROM, TO, SIZE, PUT IN, PULLED OUT. Row 1: 8 5/8", 306, None. Row 2: 5 1/2", 3760', 1105.66'

Describe in detail the manner in which the well was plugged, indicating where the mud fluid was placed and the method or methods used in introducing it into the hole. If cement or other plugs were used, state the character of same and depth placed, from feet to feet for each plug set.

5-17-72

Set plug at 3600'. Run 5 sacks of cement from 3600' to 3570'.

Shot at 1114'.

5-19-72

5 sks hulls w/water

11 sks gel

110 cu ft pozmix 50-50 6% gel

15 sks gel

Release plug

30 cu ft pozmix 50-50 6% gel

4 sks gel

10 cu ft pozmix 50-50 6% gel

Shut in psi 150 - Max. 300

RECEIVED STATE CORPORATION COMMISSION JUN 2 1972 06-02-1972 CONSERVATION DIVISION Wichita, Kansas

(If additional description is necessary, use BACK of this sheet)

Name of Plugging Contractor Glenn & Smith Pipe Pulling Co.
Address Box 156, Ellinwood, Kansas

STATE OF KANSAS, COUNTY OF SEDGWICK, ss. I. Theodore Gore

(employee of owner) or (owner or operator) of the above-described well, being first duly sworn on oath, says: That I have knowledge of the facts, statements, and matters herein contained and the log of the above-described well as filed and that the same are true and correct. So help me God.

(Signature) Theodore Gore

650 Fourth National Building, Wichita, Kans. 67202 (Address)

SUBSCRIBED AND SWORN TO before me this 1st day of June, 1972

My commission expires October 21, 1974

Notary Public.

