


STATE CORPORATION COMMISSION

Give All Information Completely
 Make Required Affidavit
 Mail or Deliver Report to:
 Conservation Division
 State Corporation Commission
 211 No. Broadway
 Wichita, Kansas

WELL PLUGGING RECORD
 15-137-00144-00-00

Norton County, Sec. 2 Twp. 4 Rge. (E) 24 (W)

Location as "NE/CNW%SW%" or footage from lines NE NE NW
 Lease Owner Theodore Gore
 Lease Name Henry Well No. 1
 Office Address 650 Fourth Nat'l Bank Bldg., Wichita, Kansas
 Character of Well (completed as Oil, Gas or Dry Hole) Oil
 Date well completed July 1954
 Application for plugging filed March 1972
 Application for plugging approved April 5 1972
 Plugging commenced May 11, 1972
 Plugging completed May 19, 1972
 Reason for abandonment of well or producing formation Well not profitable.

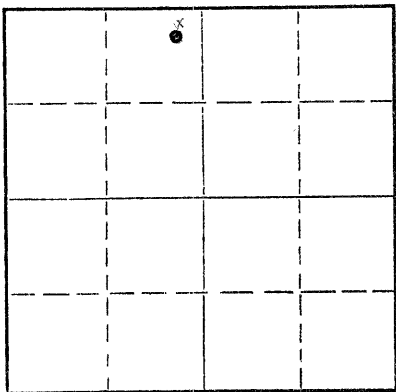

Locate well correctly on above Section Plat

If a producing well is abandoned, date of last production March 22, 1972
 Was permission obtained from the Conservation Division or its agents before plugging was commenced? yes

Name of Conservation Agent who supervised plugging of this well W. L. Nichols
 Producing formation Arbuckle Depth to top 3736' Bottom _____ Total Depth of Well 3737 Feet
 Show depth and thickness of all water, oil and gas formations.

OIL, GAS OR WATER RECORDS

CASING RECORD

FORMATION	CONTENT	FROM	TO	SIZE	PUT IN	PULLED OUT
				8 5/8"	264'	None
				5 1/2"	3734'	1014.68'

Describe in detail the manner in which the well was plugged, indicating where the mud fluid was placed and the method or methods used in introducing it into the hole. If cement or other plugs were used, state the character of same and depth placed, from _____ feet to _____ feet for each plug set.

5-11-72

Filled with sand from 3737' to 3700'. Run 5 sacks of cement from 3700' to 3670'. Shot at 1011'.

5-19-72

5 sks hulls w/water
 11 sks gel
 110 cu ft pozmix 50-50 6% gel
 15 sks gel
 release plug
 30 cu ft pozmix 50-50 6% gel
 Shut in psi 150 - Max. 300
 4 sks gel
 10 cu ft pozmix 50-50 6% gel

RECEIVED
 STATE CORPORATION COMMISSION
 JUN 2 1972
 06-02-1972
 CONSERVATION DIVISION
 Wichita, Kansas

(If additional description is necessary, use BACK of this sheet)

Name of Plugging Contractor Glean & Smith Pipe Pulling Co.
 Address Box 156, Ellinwood, Kansas

STATE OF KANSAS, COUNTY OF SEDGWICK, ss.


I, Theodore Gore (employee of owner) do hereby certify that I am the owner/operator of the above-described well, being first duly sworn on oath, says: That I have knowledge of the facts, statements, and matters herein contained and the log of the above-described well as filed and that the same are true and correct. So help me God.

(Signature) Theodore Gore

Theodore Gore
650 Fourth National Building, Wichita, Kans. 67202
 (Address)

SUBSCRIBED AND SWORN TO before me this 1st day of June, 19 72

My commission expires October 21, 1974

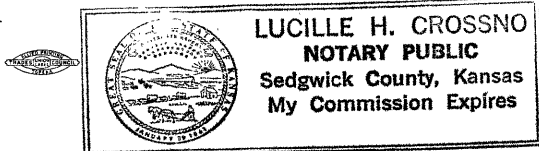

Notary Public.