


STATE OF KANSAS
STATE CORPORATION COMMISSION

15-153-00028-00-00
WELL PLUGGING RECORD

Give All Information Completely
Make Required Affidavit
Mail or Deliver Report to:
Conservation Division
State Corporation Commission
211 No. Broadway
Wichita, Kansas

Rawlins County. Sec. 23 Twp. 4S Rge. 33 ~~XOEXX~~ (W)
Location as "NE/CNW $\frac{1}{2}$ SW $\frac{1}{2}$ " or footage from lines NW/4-NW/4-NW/4
Lease Owner Amerada Petroleum Corporation
Lease Name A.J. Ruda Tract 1 Well No. 1
Office Address Box 197, Great Bend, Kansas
Character of Well (completed as Oil, Gas or Dry Hole) _____
Date well completed 1-21-1959
Application for plugging filed 1-20-1959
Application for plugging approved 1-21-1959
Plugging commenced 1-21-1959
Plugging completed 6:00 AM 1-21-1959
Reason for abandonment of well or producing formation Dry Hole

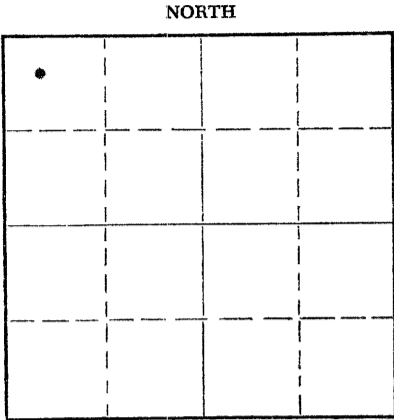

Locate well correctly on above
Section Plat

If a producing well is abandoned, date of last production _____ 19____
Was permission obtained from the Conservation Division or its agents before plugging was commenced? Yes

Name of Conservation Agent who supervised plugging of this well A.D. Fabricius
Producing formation _____ Depth to top _____ Bottom _____ Total Depth of Well _____ Feet
Show depth and thickness of all water, oil and gas formations.

OIL, GAS OR WATER RECORDS

CASING RECORD

FORMATION	CONTENT	FROM	TO	SIZE	PUT IN	PULLED OUT
				8-5/8"	263'	None

Describe in detail the manner in which the well was plugged, indicating where the mud fluid was placed and the method or methods used in introducing it into the hole. If cement or other plugs were used, state the character of same and depth placed, from _____ feet to _____ feet for each plug set.

Spotted Cement Plug thru 4 1/2" Drill Pipe as Follows:

20 Sax, 600' to 680'
20 Sax, 260' to 340'
10 Sax, 0' to 40'

RECEIVED
STATE CORPORATION COMMISSION
JAN 28 1959
01-28-59
CONSERVATION DIVISION
Wichita, Kansas

(If additional description is necessary, use BACK of this sheet)

Name of Plugging Contractor Badger Driller Inc.
Address Mayo Bldg. - Tulsa, Oklahoma

STATE OF Kansas, COUNTY OF Barton, ss.
Ernest Higgins (employee of owner) or (owner or operator) of the above-described well, being first duly sworn on oath, says: That I have knowledge of the facts, statements, and matters herein contained and the log of the above-described well as filed and that the same are true and correct. So help me God.

(Signature) Ernest Higgins
Box 197, Great Bend, Kansas
(Address)

SUBSCRIBED AND SWORN TO before me this 21st day of January, 19 59

Charles H. Anderson
Notary Public.

My commission expires November 21, 1961

PLUGGING
FILE SEC. 23 T. 4 R. 33W
BOOK PAGE 12 LINE 17

15-153-00028-00-00

AMERADA PETROLEUM CORPORATION
NW/4 NW/4 NW/4 of Section 23-4S-3W 33 W
Rawlins County, Kansas

Ruda No. 1

<u>From</u>	<u>To</u>	<u>Formation</u>	<u>Remarks</u>
0	187	Sandy Shale	
187	270	Shale	Ran 7 jts of 8-5/8" casing, set at
270	820	Shale	263' with 225 sacks cement
820	1150	Sandy Shale & Sand	
1150	2280	Shale & Shells	
2280	2330	Anhydrite	
2330	2380	Shale & Shells	
2380	2705	Red Bed, Shale & Shells	
2705	3792	Shale & Lime	
3792	3920	Lime	
3920	3954	Lime & Shale	
3954	4239	Lime	
4239	4313	Lime & Shale	
4313	4470	Lime	
4470	4493	Lime (Mississippi)	TD. Dry hole.

I certify the above to be a true and exact copy of the Driller's Log as shown by the Daily Drilling Reports.

BADGER DRILLERS, INC.

J.C. Canabun

Subscribed and sworn to before me
this 4th day of February, 1959.

Lewis W. Jackson
Notary Public

My commission expires September 28, 1961

RECEIVED
STATE CORPORATION COMMISSION

FEB 11 1959

PLUGGING
FILE SEC. 23 T. 4 R. 33 W
BOOK PAGE 12 LINE 17