

STATE OF KANSAS  
STATE CORPORATION COMMISSION


15-153-00028-00-02

WELL PLUGGING RECORD

Give All Information Completely  
Make Required Affidavit  
Mail or Deliver Report to  
Conservation Division  
State Corporation Comm.  
245 North Water  
Wichita, KS 67202

Rawlins County, Sec. 23 Twp. 4 Rge. 33 N/W  
Location as "NE/CNW/SW" or footage from lines  
NW NW NW

Lease Owner Ruda  
Lease Name Ruda Exploration Well No. 2  
Office Address RT 1 Box 87  
Character of Well (Completed as Oil, Gas or Dry Hole) Oil then SWD  
Date Well completed April 1989  
Application for plugging filed March Jan 1989  
Application for plugging approved March 1989  
Plugging commenced 4-5-89 1989  
Plugging completed 4-5-89 1989  
Reason for abandonment of well or producing formation No more oil!

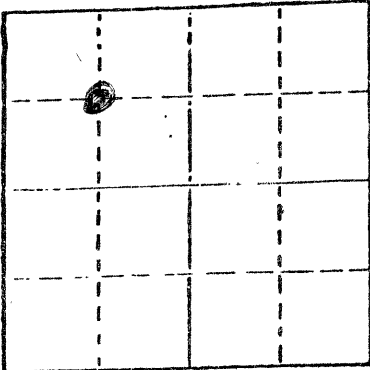

Locate well correctly on above  
Section Plat

If a producing well is abandoned, date of last production Unknown 19      
Was permission obtained from the Conservation Division or its agents before plugging was commenced? Yes

Name of Conservation Agent who supervised plugging of this well Carl Goodrow  
Producing formation KCC Depth to top 3900 Bottom 4200 Total Depth of Well 4493  
Show depth and thickness of all water, oil and gas formations.

OIL, GAS OR WATER RECORDS

CASING RECORD

FORMATION	CONTENT	FROM	TO	SIZE	PUT IN	PULLED OUT
<u>Ogden</u>	<u>Water</u>	<u>80</u>	<u>160</u>	<u>8 5/8</u>	<u>263</u>	<u>ALL Left</u>
<u>Lan KCC</u>	<u>Oil</u>	<u>3900</u>	<u>4200</u>	<u>4 1/2</u>	<u>4350</u>	<u>In</u>

Describe in detail the manner in which the well was plugged, indicating where the mud fluid was placed and the method or methods used in introducing it into the hold. If cement or other plugs were used, state the character of same and depth placed, from      feet to      feet for each plug set. Filled with Cement with 200 Sacks - Down 4 1/2 csg run 2" tbg to 1316 Circulated cement to surface pulled tbg. Tided to 4 1/2 mixed total of 6 Sks hulls with 200 Sks cement at 300 # max press and shut in at 100 # pressured annulus 8 5/8 csg, 700/lb with 200 Sks cement shut in at 200 #

APR 12 1989

RECEIVED  
STATE CORPORATION COMMISSION  
Wichita, Kansas

(If additional description is necessary, use BACK of this form)  
Name of Plugging Contractor ALLIED Cement

STATE OF      COUNTY OF     , ss.      (employee of owner) or (owner or operator) of the above-described well, being first duly sworn on oath, says: That I have knowledge of the facts, statements, and matters herein contained and the log of the above-described well as filed and that the same are true and correct. So help me God.

(Signature) [Signature]  
RT 1 Box 87 - Rawlins KS  
(Address)

SUBSCRIBED AND SWORN TO before me this 11 day of April, 1989

[Signature]  
Notary Public.

My commission expires 5-1-93