

STATE OF KANSAS  
STATE CORPORATION COMMISSION

15-153-05139-0000

WELL PLUGGING RECORD

Give All Information Completely  
Make Required Affidavit  
Mail or Deliver Report to:  
Conservation Division  
State Corporation Commission  
211 No. Broadway  
Wichita, Kansas

RAWLINS CO., KS. County. Sec. 27 Twp. 4S Rge. 35W (E) (W)

Location as "NE/CNW/SW" or footage from lines NE NE NW

Lease Owner K & E & BRADLEY BROS.

Lease Name WALLACE Well No. 1

Office Address 719 Union Center, Wichita 2, Kansas

Character of Well (completed as Oil, Gas or Dry Hole) D & A

Date well completed July 26th, 1959 19

Application for plugging filed July 26th, 1959 19

Application for plugging approved July 26th, 1959 19


Plugging commenced July 26th, 1959 19

Plugging completed July 26th, 1959 19

Reason for abandonment of well or producing formation

If a producing well is abandoned, date of last production 19

Was permission obtained from the Conservation Division or its agents before plugging was commenced? yes

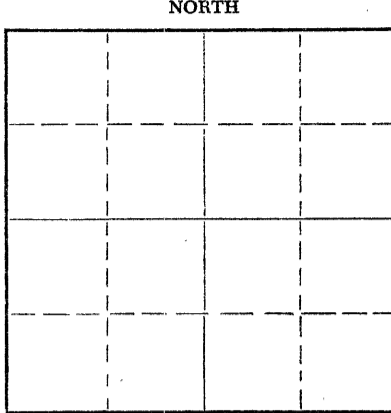

Locate well correctly on above Section Plat

Name of Conservation Agent who supervised plugging of this well

Producing formation Depth to top Bottom Total Depth of Well 4960 Feet

Show depth and thickness of all water, oil and gas formations.

OIL, GAS OR WATER RECORDS

CASING RECORD

FORMATION	CONTENT	FROM	TO	SIZE	PUT IN	PULLED OUT
				8-5/8"	350'	

Describe in detail the manner in which the well was plugged, indicating where the mud fluid was placed and the method or methods used in introducing it into the hole. If cement or other plugs were used, state the character of same and depth placed, from feet to feet for each plug set.

Filled with heavy mud to 600' set solid bridge with 20 sx cement thru drill pipe. Filled with 2 heavy mud to 345' set solid bridge with 20 sx cement thru drill pipe. Filled with heavy mud to 40' set solid bridge with 10 sx cement to base of cellar. Job complete 7-26-59.

RECEIVED  
STATE CORPORATION COMMISSION

AUG 5 1959

CONSERVATION DIVISION  
Wichita, Kansas

8-5-59

(If additional description is necessary, use BACK of this sheet)

Name of Plugging Contractor K & E DRILLING, INC.

Address 719 Union Center, Wichita 2, Kansas

STATE OF KANSAS, COUNTY OF SEDGWICK, ss.

Dale Silcott (employee of owner) or (owner or operator) of the above-described

well, being first duly sworn on oath, says: That I have knowledge of the facts, statements, and matters herein contained and the log of the above-described well as filed and that the same are true and correct. So help me God.

(Signature) Dale Silcott, of K & E DRILLING, INC.  
719 Union Center Wichita 2, Kansas

(Address)

SUBSCRIBED AND SWORN TO before me this 29th day of July, 19 59

My commission expires August 11th, 1962.

Patricia M. Edwards, Notary Public.

PLUGGING  
FILE SEC 27 T. 4 R 35W  
BOOK PAGE 53 LINE 39

15-153-09139-00-00

# DRILLER'S WELL LOG

OPERATOR: **K & E & BRADLEY BROS.**  
719 Union Center Building  
Wichita 2, Kansas

WELL NAME: **#1 WALLACE**  
LOCATION: **NE NE NW**  
**Section 27-4S-35W**  
**RAWLINS COUNTY, KANSAS**

CONTRACTOR: **K & E DRILLING, INC.**  
719 UNION CENTER BLDG.  
WICHITA, KANSAS

COMMENCED: **July 13th, 1959**

CASING RECORD: **8-5/8" @ 350 (250 sz cmt)**

COMPLETED: **July 26th, 1959**

ELEVATION: **3155' KB**

ROTARY TOTAL DEPTH: **4960'**

PRODUCTION: **D & A**

## FORMATION RECORD

*Depths shown indicate bottom of formations encountered.*

S	Lime & Shale	105
	Sand & Shale	160
	Shale	1625
	Shale & Shells	1790
	Lime & Shale	2535
	Anhydrite	2560
	Lime & Shale	2868
	Anhydrite	2900
	Lime & Shale	3225
	Lime, Shale & Red Bed	3380
	Lime	3715
	Lime & Shale	3825
	Lime	4325
	Lime & Shale	4380
	Lime	4545
	Shale & Lime	4600
	Sand, Shale & Lime	4645
	Lime & Shale	4685
	Lime	4735
	Chert & Lime	4795
	Chert	4815
	Lime	4890
	Arbuckle	4960
	R.T.D.	4960

RECEIVED  
STATE OF KANSAS  
AUG 11 1959  
CONSERVATION DIVISION  
Wichita, Kansas

## CERTIFICATION

State of KANSAS }  
County of SEDGWICK } ss:

I, Dale Silcott, of K&E DRILLING, INC., upon oath state that the above and foregoing is a true and correct copy of the Driller's Log of the above named well.

*Dale Silcott*  
Dale Silcott

Subscribed and sworn to before me this 29th day of July, 19 59.

*Patricia M. Edwards*  
Patricia M. Edwards, Notary Public.

My Commission expires: August 11th, 1962.

PLUGGING  
FILE SEC. 27 T 4 R 35W  
BOOK PAGE 53 LINE 35

