


15-153-20148-00-00

STATE OF KANSAS
STATE CORPORATION COMMISSION

Form CP-4

WELL PLUGGING RECORD

Give All Information Completely
Make Required Affidavit
Mail or Deliver Report to:
Conservation Division
State Corporation Commission
P. O. Box 17027
Wichita, Kansas 67217
NORTH

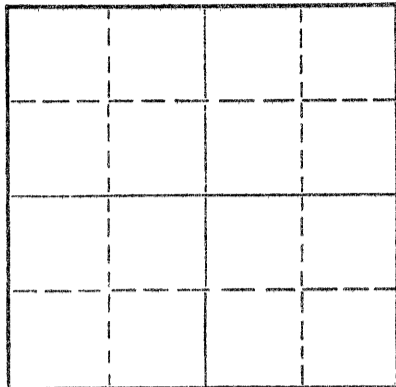

Locate well correctly on above
Section Plat

Rawlins County. Sec. 23 Twp. 4S Rge. (E) 35 (W)
Location as "NE/CNW/SW" or footage from lines C NW NW
Lease Owner Beacon Resources
Lease Name Chandler-Weber Well No. 1
Office Address 1000 Century Plaza, Wichita, Kansas 67202
Character of Well (completed as Oil, Gas or Dry Hole) Dry Hole
Date well completed 2-22 1973
Application for plugging filed 2-22 1973
Application for plugging approved 2-22 1973
Plugging commenced 2-22 1973
Plugging completed 2-22 1973
Reason for abandonment of well or producing formation Dry Hole

If a producing well is abandoned, date of last production 19
Was permission obtained from the Conservation Division or its agents before plugging was commenced? Bill Nichols, Morland, Kansas - Yes

Name of Conservation Agent who supervised plugging of this well Bill Nichols, Morland, Kansas
Producing formation Depth to top Bottom Total Depth of Well 4734 Feet
Show depth and thickness of all water, oil and gas formations.

OIL, GAS OR WATER RECORDS

CASING RECORD

FORMATION	CONTENT	FROM	TO	SIZE	PUT IN	PULLED OUT

Describe in detail the manner in which the well was plugged, indicating where the mud fluid was placed and the method or methods used in introducing it into the hole. If cement or other plugs were used, state the character of same and depth placed, from feet to feet for each plug set.

PLUGGED 1st Plug @ 2000' w/110 sx
2nd Plug @ 310' w/30 sx
3rd Plug @ 40' w/10 sx


RECEIVED
STATE CORPORATION COMMISSION
FEB 28 1973
CONSERVATION DIVISION
Wichita, Kansas

2-28-73

(If additional description is necessary, use BACK of this sheet)
Name of Plugging Contractor Sun Oil Well Cementing, Inc.
Address Box 169, Great Bend, Kansas

STATE OF Kansas, COUNTY OF Sedgwick ss.
I, James R. Daniels (employee of owner) or (owner or operator) of the above-described well, being first duly sworn on oath, says: That I have knowledge of the facts, statements, and matters herein contained and the log of the above-described well as filed and that the same are true and correct. So help me God.

(Signature) James R. Daniels
617 Union Center, Wichita, Kansas 67202
(Address)

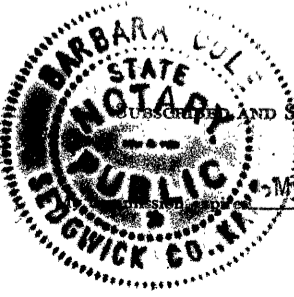

Subscribed and sworn to before me this 27 day of February, 1973.
BARBARA COLE, Notary Public
My Commission Expires Sept. 5, 1976
Notary Public.