

15-153-05199-00-00

WELL PLUGGING RECORD

OR

FORMATION PLUGGING RECORD

Strike out upper line when reporting plugging of formations.

STATE OF KANSAS
STATE CORPORATION COMMISSION

Give All Information Completely
Make Required Affidavit
Mail or Deliver Report to:
Conservation Division
State Corporation Commission
800 Bittling Building
Wichita, Kansas

Rawlins

County. Sec. 14 Twp. 4S Rge. (E) 35W(W)

Location as "NE $\frac{1}{4}$ NW $\frac{1}{4}$ SW $\frac{1}{4}$ " or footage from lines 2310' W and 330' N of SE corner

Lease Owner Stanolind Oil & Gas Company

Lease Name Elmer S. Mullen

Well No. 1

Office Address Box 801 Tulsa, Oklahoma

Character of Well (completed as Oil, Gas or Dry Hole) ~~Dry Hole~~ Stratigraphic

Date, well completed June 23 19 44

Application for plugging filed 19

Application for plugging approved 19

Plugging Commenced June 23 19 44


Plugging Completed June 23 19 44

Reason for abandonment of well or producing formation

If a producing well is abandoned, date of last production 19

Was permission obtained from the Conservation Division or its agents before plugging was commenced?

NORTH

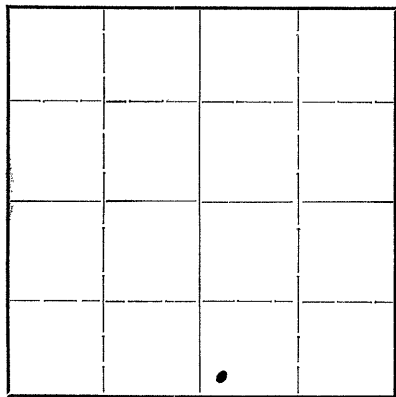

Locate well correctly on above Section Plat

Name of Conservation Agent who supervised plugging of this well

Producing formation Depth to top Bottom Total Depth of Well Feet

Show depth and thickness of all water, oil and gas formations.

OIL, GAS OR WATER RECORDS


CASING RECORD

Formation	Content	From	To	Size	Put In	Pulled Out
				13"	277'	None - Cemented top to bottom

Describe in detail the manner in which the well was plugged, indicating where the mud fluid was placed and the method or methods used in introducing it into the hole. If cement or other plugs were used, state the character of same and depth placed, from feet to feet for each plug set.

Circulated heavy mud top to bottom. Dumped 20 sacks cement to bottom of cellar. 20 sacks cement at 200 feet. Cap welded on top of surface pipe.

PLUGGING
FILE 14 4 R 35W
121 WS 33

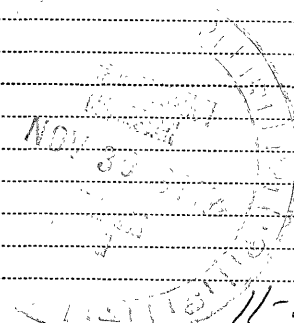

(If additional description is necessary, use BACK of this sheet)

Correspondence regarding this well should be addressed to Address

STATE OF Oklahoma, COUNTY OF Tulsa, ss. Herrick Babcock

(employee of owner) or (owner or operator) of the above-described well, being first duly sworn on oath, says: That I have knowledge of the facts, statements, and matters herein contained and the log of the above-described well as filed and that the same are true and correct. So help me God.

(Signature) *Herrick Babcock*

1206 Philtower Tulsa, Oklahoma (Address)

SUBSCRIBED AND SWORN to before me this 28th day of November, 19 44

B. Michal Notary Public

My commission expires Feb. 28, 1948

STANOLIND OIL AND GAS COMPANY

FIRST NATIONAL BANK BLDG.

WICHITA, KANSAS

November 29, 1944

15-153-05199-00-00

Plugging Records
Stratigraphic Tests
K a n s a s

Mr. T.A. Morgan
Kansas State Corporation Commission
Bitting Building
Wichita, Kansas

Dear Mr. Morgan:

Attached are plugging affidavits covering the plugging of a stratigraphic test known as the Stanolind No. 1 Mullen, Sec. 14-4S-35W, Rawlins County, and a stratigraphic test known as the Stanolind No. 1 Bryan, Sec. 12-5S-31W, Rawlins County. These stratigraphic tests were plugged on June 23, 1944 and August 11, 1944, respectively.

Yours very truly,

W.C. Imbt

W.C. Imbt

WCI:m

Att.

cc: Mr. V.G. Hill
Mr. T.L. Regan

PLUGGING
FILE NO. 14 4 35W
PAGE 121 LINE 33

