


STATE OF KANSAS  
STATE CORPORATION COMMISSION

15-153-20042-00-20 Form CP-4

Give All Information Completely  
Make Required Affidavit  
Mail or Deliver Report to:  
Conservation Division  
State Corporation Commission  
212 No. Market  
Wichita, Kansas

WELL PLUGGING RECORD

NORTH

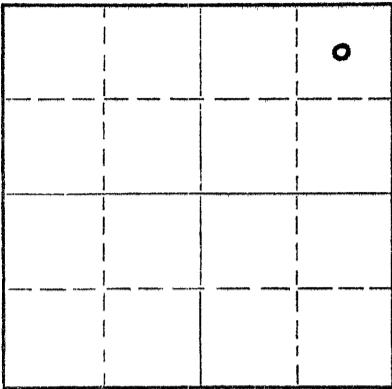

Locate well correctly on above Section Plat

Rawlins County, Sec. 10 Twp. 4S Rge. (E) 35 (W)

Location as "NE/CNW/SW" or footage from lines C NE/4 NE/4

Lease Owner Stonehenge Oil Company, Inc.

Lease Name Mayfield Well No. 1

Office Address 711 Franklin Bldg., Tulsa, Oklahoma 74103

Character of Well (completed as Oil, Gas or Dry Hole) Dry Hole

Date well completed June 9 19 69

Application for plugging filed June 8 19 69

Application for plugging approved (Verral) June 9 19 69

Plugging commenced June 9 19 69

Plugging completed 2:45 P.M. June 9 19 69

Reason for abandonment of well or producing formation Dry Hole

If a producing well is abandoned, date of last production -- 19

Was permission obtained from the Conservation Division or its agents before plugging was commenced? Yes

Name of Conservation Agent who supervised plugging of this well W. L. Nichols, Moreland, Kansas

Producing formation None Depth to top -- Bottom -- Total Depth of Well 5110 Feet

Show depth and thickness of all water, oil and gas formations.

OIL, GAS OR WATER RECORDS

CASING RECORD

FORMATION	CONTENT	FROM	TO	SIZE	PUT IN	PULLED OUT
Topeka	Dry	3963	4062	8 5/8	296'	None
Kansas City	"	4154	4424			
Marmaton	"	4520	4630			
Mississippian	"	4802	5004			
Arbuckle	"	5004	5110			

Describe in detail the manner in which the well was plugged, indicating where the mud fluid was placed and the method or methods used in introducing it into the hole. If cement or other plugs were used, state the character of same and depth placed, from feet to feet for each plug set.

Rotary hole was full of drilling mud at time plugging began. Cement plugs were spotted through drill pipe using Halliburton pump truck. 100 sack cement plug from 1595' to 1950'; 25 sack cement plug from 275' to 335'; top of 8 5/8" surface casing left open -- landowner plans to utilize as fresh water well.

RECEIVED  
STATE CORPORATION COMMISSION  
JUN 13 1969  
CONSERVATION DIVISION  
Wichita, Kansas

6-13-69

(If additional description is necessary, use BACK of this sheet)

Name of Plugging Contractor --

Address --

STATE OF OKLAHOMA, COUNTY OF TULSA, ss.  
Willard L. Roy

(employee of owner) or (owner or operator) of the above-described well, being first duly sworn on oath, says: That I have knowledge of the facts, statements, and matters herein contained and the log of the above-described well as filed and that the same are true and correct. So help me God.

(Signature) Willard L. Roy

711 Franklin Bldg., Tulsa, Oklahoma 74103  
(Address)

SUBSCRIBED AND SWORN TO before me this 11th day of June 19 69

My Commission Expires October 20, 1971

My commission expires

Charles Z. Long  
Notary Public.