


Give All Information Completely
Make Required Affidavit
Mail or Deliver Report to:
Conservation Division
State Corporation Commission
212 North Market, Insurance Bldg.
Wichita, Kansas

WELL PLUGGING RECORD

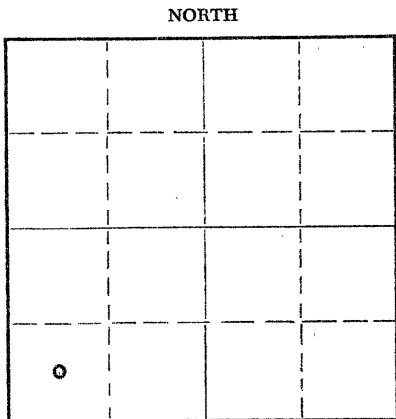

Locate well correctly on above Section Plat

Rawlins County. Sec. 28 Twp. 4s Rge. 34 (E) W (W)
Location as "NE/CNW $\frac{1}{2}$ SW $\frac{1}{2}$ " or footage from lines C SW SW
Lease Owner A. K. Mery & Inter-Trans., Inc.
Lease Name Nash Well No. 1
Office Address 1046 Milan Building, San Antonio, Texas
Character of Well (completed as Oil, Gas or Dry Hole) dry hole
Date well completed August 19 19 59
Application for plugging filed August 19 19 59
Application for plugging approved August 19 19 59
Plugging commenced 1:00 p.m., August 19 19 59
Plugging completed 5:00 p.m., August 19 19 59
Reason for abandonment of well or producing formation
dry hole

If a producing well is abandoned, date of last production _____ 19____
Was permission obtained from the Conservation Division or its agents before plugging was commenced? yes

Name of Conservation Agent who supervised plugging of this well Gilbert Leiker, Victoria, Kansas
Producing formation _____ Depth to top _____ Bottom _____ Total Depth of Well 4797 Feet
Show depth and thickness of all water, oil and gas formations.

OIL, GAS OR WATER RECORDS

CASING RECORD

FORMATION	CONTENT	FROM	TO	SIZE	PUT IN	PULLED OUT
		0	306	8-5/8"	306	none

Describe in detail the manner in which the well was plugged, indicating where the mud fluid was placed and the method or methods used in introducing it into the hole. If cement or other plugs were used, state the character of same and depth placed, from _____ feet to _____ feet for each plug set.

- Hole filled with heavy mud to 600 feet.
- Bottom plug set @ 600 feet; 30 sacks cement displaced through drill pipe.
- Hole filled with heavy mud to 300 feet.
- Plug set @ 300 feet; 20 sacks cement displaced through drill pipe.
- Hole left open above bridging plug @ 300 to enable the landowner to use the cased hole as a fresh water well.

RECEIVED
STATE CORPORATION COMMISSION
AUG 24 1959
CONSERVATION DIVISION
Wichita, Kansas

(If additional description is necessary, use BACK of this sheet)
Name of Plugging Contractor Interstate Drilling Company 824-59
Address Midland, Texas

STATE OF Kansas, COUNTY OF Sedgwick, ss.
Richard G. Smith (employee of owner) or (~~owner or operator~~) of the above-described well, being first duly sworn on oath, says: That I have knowledge of the facts, statements, and matters herein contained and the log of the above-described well as filed and that the same are true and correct. So help me God.
(Signature) Richard G. Smith
301 Beacon Building, Wichita, Kansas
(Address)

SUBSCRIBED AND SWORN TO before me this 22 day of August, 19 59

My commission expires July 2, 1962

Jo Ann Grest
Notary Public.

PLUGGING
FILE SEC 28 T. 4 R 34
BOOK PAGE 44 LINE 26

A. K. MERY & INTER-TRANS, INC.



STATE OF KANSAS
STATE CORPORATION COMMISSION
CONSERVATION DIVISION
800 BITTING BUILDING
WICHITA, KANSAS

15-153-00046-00-00

211 No. Broadway

AUTHORIZATION

The undersigned, owner of the following described land, to
wit: Southwest Quarter (SW¹) of Sec. 28 Twp. 4s. Rge. 34 W
Bawling County, Kansas; hereby requests that
Well No. 1 located in C SW SW of Sec. 28 Twp. 4s. Rge. 34 W
be left open above the fresh water protecting bridge set at
300 feet, to be used as a fresh water well and I hereby
authorize A. K. Mery & Inter-Trans, Inc., well owner, to
so complete the abandonment of said well.

Witnessed by [Signature] C. G. Nash
(Land Owner)

Dated at Atwood, Kansas, this 3rd day of
September, 1959.

RECEIVED
STATE CORPORATION COMMISSION
OCT 19 1959
CONSERVATION DIVISION
WICHITA, KANSAS