

15-153-30154-00-00


WELL PLUGGING RECORD

Give All Information Completely  
Make Required Affidavit  
Mail or Deliver Report to:  
Conservation Division  
State Corporation Commission  
211 No. Broadway  
Wichita, Kansas

Rawlins County. Sec. 27 Twp. 4S Rge. (E) 34 (W)

Location as "NE/CNW/SW" or footage from lines NW SE  
Lease Owner Arvel C. Smith  
Lease Name Leebrick Well No. 1  
Office Address 534 N. Tallyrand, Wichita 6, Kansas  
Character of Well (completed as Oil, Gas or Dry Hole) Dry Hole  
Date well completed November 4, 1965  
Application for plugging filed " " 19"  
Application for plugging approved " " 19"  
Plugging commenced " " 19"  
Plugging completed " " 19"  
Reason for abandonment of well or producing formation Dry Hole

NORTH

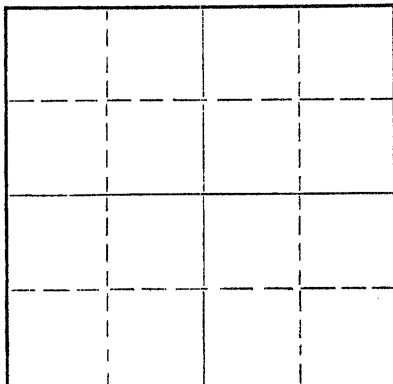

Locate well correctly on above  
Section Plat

If a producing well is abandoned, date of last production 19  
Was permission obtained from the Conservation Division or its agents before plugging was commenced? Yes

Name of Conservation Agent who supervised plugging of this well W. L. Nichols, Morland, Kansas  
Producing formation Depth to top Bottom Total Depth of Well 4725 Feet

Show depth and thickness of all water, oil and gas formations.

OIL, GAS OR WATER RECORDS

CASING RECORD

FORMATION	CONTENT	FROM	TO	SIZE	PUT IN	PULLED OUT
	surface Pipe	o	279'	8 5/8"		NO

Describe in detail the manner in which the well was plugged, indicating where the mud fluid was placed and the method or methods used in introducing it into the hole. If cement or other plugs were used, state the character of same and depth placed, from feet to feet for each plug set.

- 0' - 250' \*\* see below
- 250' - 300' Twenty sack cement Plug
- 300' - 630' Heavy Mud
- 630' - 700' Twenty sack cement Plug
- 700' - T. D. Heavy Mud.

\*\* Landowner wants to use upper portion of hole as a water well. With permission of Conservation Agent we left unplugged that portion of hole from 250' to surface. Landowner has assumed responsibility.

RECEIVED  
STATE CORPORATION COMMISSION

NOV 9 1965

CONSERVATION DIVISION  
Wichita, Kansas

11-9-65

(If additional description is necessary, use BACK of this sheet)

Name of Plugging Contractor Stoepelwerth Drilling, Inc.  
Address Russell, Kansas

STATE OF Kansas COUNTY OF Sedgwick, ss.  
Arvel C. Smith (employee of owner) or (owner or operator) of the above-described

well, being first duly sworn on oath, says: That I have knowledge of the facts, statements, and matters herein contained and the log of the above-described well as filed and that the same are true and correct. So help me God.

(Signature) Arvel C. Smith  
534 N. Tallyrand, Wichita 6, Kansas  
(Address)

SUBSCRIBED AND SWORN TO before me this 8th day of November, 1965

My commission expires My Commission Expires Nov. 12, 1969

Barbara F. Smith  
Barbara F. Smith Notary Public.



State of Kansas



15-153-30154-00-00

JOHN ANDERSON, Jr. Governor  
 WILLIAM L. MITCHELL, Chairman  
 ALVIN F. GRAUERHOLZ Commissioner  
 HARRY G. WILES Commissioner  
 RAYMOND B. HARVEY Secretary  
 ROBT. C. LONDERHOLM Gen. Counsel

RECEIVED  
 STATE CORPORATION COMMISSION

State Corporation Commission

CONSERVATION DIVISION

(Oil, Gas and Water)

500 Insurance Bldg. 212 N. Market  
 WICHITA, KANSAS 67202

NOV 18 1965  
 11-18-65  
 CONSERVATION DIVISION  
 WICHITA, KANSAS

AUTHORIZATION

The undersigned, owner of the following described land, to  
 wit: SE 1/4 of Sec. 27 Twp. 4S Rge. 34 <sup>E</sup>W  
RAWLINS County, Kansas; hereby requests  
 that Well No. 1 located in NWSE of Sec. 27 Twp. 4S  
<sup>E</sup>Rge. 34 W be left open above the fresh water protecting  
 bridge set at 250 feet, to be used as a fresh water well  
 and I hereby authorize AC. SMITH & B. J. TAYLOR,  
 well owner, to so complete the abandonment of said well.

Witnessed by [Signature] [Signature]  
 (Land Owner)

Dated at Atwood, Kansas, this 13 day of  
November, 1965

15-153-30154-00-00

DRILLER'S LOG

A. C. Smith - BEN J. TAYLOR NO. 1 LEEBRICK  
C NW SE Sec. 27-4S-34W  
Rawlins County, Kansas

Commenced drilling: October 23, 1965

Completed drilling: November 4, 1965

Elevation: 3150' GL

Set 8 5/8" surface casing at 289 feet; cemented to surface.

Formation Record:

0 - 300'	Soil, shale and sand
300 - 1630'	Shale
1630 - 1750'	Lime and shale
1750 - 2850'	Sand, shale and dolomite
2850 - 3800'	Anhydrite, shale and sand
3800 - 4540'	Lime and shale
4540 - 4650'	Sand and shale
4650 - 4725'	Lime
4725'	Total Depth

**RECEIVED**  
STATE CORPORATION COMMISSION

NOV 19 1965  
11-19-65  
CONSERVATION DIVISION  
Wichita, Kansas

Plugged and abandoned: 20 sack cement plug at 630' to 700';  
20 sack cement plug at 250' to 300';  
2 sacks of cement in rat hole.  
Farmer wants hole for water well.

I hereby certify that the above and foregoing is a true and accurate report of the drilling and abandonment of the well described.

Dated November 8, 1965.

Ben J. Taylor

Subscribed and sworn to before me, a Notary Public in and for Oklahoma County, Oklahoma, this 8th day of November, 1965.

James B. Reid  
Notary Public

My commission expires 9-16-68.