


STATE OF KANSAS  
STATE CORPORATION COMMISSION

15-153-00012-0000

Give All Information Completely  
Make Required Affidavit  
Mail or Deliver Report to:  
Conservation Division  
State Corporation Commission  
211 No. Broadway  
Wichita, Kansas

WELL PLUGGING RECORD

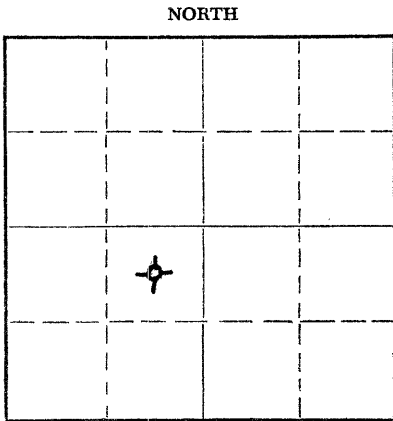

Locate well correctly on above  
Section Plat

Rawlins County, Sec. 24 Twp. 3-S Rge. 34 (E) W (W)  
Location as "NE/CNW/SW" or footage from lines. C NE SW  
Lease Owner Miles Jackson Drilling Company  
Lease Name Bowles Well No. 1  
Office Address Box 149, Duncan, Oklahoma  
Character of Well (completed as Oil, Gas or Dry Hole) Dry Hole  
Date well completed May 15, 19 59  
Application for plugging filed May 15, 19 59  
Application for plugging approved May 15, 19 59  
Plugging commenced 7:00 P.M. - May 15, 19 59  
Plugging completed 11:00 P.M. - May 15, 19 59  
Reason for abandonment of well or producing formation Dry Hole

If a producing well is abandoned, date of last production - 19  
Was permission obtained from the Conservation Division or its agents before plugging was commenced? Yes

Name of Conservation Agent who supervised plugging of this well A. D. Fabricus  
Producing formation \_\_\_\_\_ Depth to top \_\_\_\_\_ Bottom \_\_\_\_\_ Total Depth of Well 4470 Feet  
Show depth and thickness of all water, oil and gas formations.

OIL, GAS OR WATER RECORDS

CASING RECORD

FORMATION	CONTENT	FROM	TO	SIZE	PUT IN	PULLED OUT
				9 5/8"	300'	None

Describe in detail the manner in which the well was plugged, indicating where the mud fluid was placed and the method or methods used in introducing it into the hole. If cement or other plugs were used, state the character of same and depth placed, from \_\_\_\_\_ feet to \_\_\_\_\_ feet for each plug set.

Plug from 600' to 575' (20 sacks cement)  
Plug from 295' to 270' (20 sacks cement)  
Plug from 40' to 30' (10 sacks cement)

(If additional description is necessary, use BACK of this sheet)  
Name of Plugging Contractor Miles Jackson Drilling Company  
Address Box 149, Duncan, Oklahoma

STATE OF Oklahoma, COUNTY OF Stephens, ss.  
Miles Jackson ~~owner~~ (owner or operator) of the above-described well, being first duly sworn on oath, says: That I have knowledge of the facts, statements, and matters herein contained and the log of the above-described well as filed and that the same are true and correct. So help me God.

(Signature) Miles Jackson  
Box 149, Duncan, Oklahoma  
(Address)

SUBSCRIBED AND SWORN to before me this 18th day of May, 19 59

My commission expires June 26, 1962

RECEIVED  
STATE CORPORATION COMMISSION  
JUN 6 1959 6-6-59  
CONSERVATION DIVISION  
Wichita, Kansas

PLUGGING  
FILE SEC. 24 T. 4 R. 34  
BOOK PAGE 22 LINE 31