

15-153-30152-00-00

STATE OF KANSAS  
STATE CORPORATION COMMISSION


Give All Information Completely  
Make Required Affidavit  
Mail - Deliver Report to:  
Conservation Division  
State Corporation Commission  
1001 No. Broadway  
Wichita, Kansas

WELL PLUGGING RECORD

Rawlins County. Sec. 23 Twp. 4S Rge. (E) 34 (W)

Location as "NE/CNW/SW" or footage from lines 1980' FEL, 660' FNL of SE/4  
Lease Owner Phillips Petroleum Company  
Lease Name Reeves "A" Well No. 2  
Office Address Box 287 - Gt. Bend, Kansas.  
Character of Well (completed as Oil, Gas or Dry Hole) Dry hole  
Date well completed November 17, 1961 19  
Application for plugging filed November 17, 1961 19  
Application for plugging approved November 17, 1961 19  
Plugging commenced November 18, 1961 19  
Plugging completed November 18, 1961 19  
Reason for abandonment of well or producing formation Dry hole

NORTH

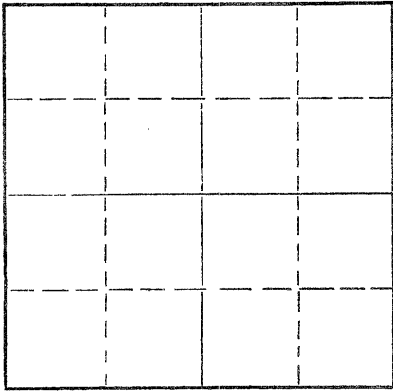

Locate well correctly on above  
Section Plat

If a producing well is abandoned, date of last production 19  
Was permission obtained from the Conservation Division or its agents before plugging was commenced? yes

Name of Conservation Agent who supervised plugging of this well Mr. Eldon Petty  
Producing formation \_\_\_\_\_ Depth to top \_\_\_\_\_ Bottom \_\_\_\_\_ Total Depth of Well \_\_\_\_\_ Feet  
Show depth and thickness of all water, oil and gas formations.

OIL, GAS OR WATER RECORDS

CASING RECORD

FORMATION	CONTENT	FROM	TO	SIZE	PUT IN	PULLED OUT
Howard	Dry	3838		85/8"	310.96	None
Topeka	Dry	3878				
Heebner	Dry	4007				
Toronto	Dry	4039				
LKC	Dry	4050	4290			
Drym	Dry	4170				
Marmaton	Dry	4304				
Cherokee	Dry	4462		Mississippi = 4614		

Describe in detail the manner in which the well was plugged, indicating where the mud fluid was placed and the method or methods used in introducing it into the hole. If cement or other plugs were used, state the character of same and depth placed, from \_\_\_\_\_ feet to \_\_\_\_\_ feet for each plug set.

Mudded hole from 4650' to 550'. Set wood plug at 550' and dumped 20 sx. cement to 480'. Mudded to 240', set wood plug at 240' and dumped 20 sx. cement to 180'. Mudded to 40'. Set wood plug at 40' and filled to base of cellar with cement.

RECEIVED  
STATE CORPORATION COMMISSION

NOV 21 1961

CONSERVATION DIVISION  
Wichita, Kansas

11-21-61

(If additional description is necessary, use BACK of this sheet)

Name of Plugging Contractor Garvey Drilling Company  
Address Gt. Bend, Ks.

STATE OF KANSAS, COUNTY OF BARTON, ss.  
M. E. Michael (employee of owner) of the above-described well, being first duly sworn on oath, says: That I have knowledge of the facts, statements, and matters herein contained and the log of the above-described well as filed and that the same are true and correct. So help me God.

(Signature) M. E. Michael

Box 287 - Gt. Bend, Kansas.  
(Address)

SUBSCRIBED AND SWORN TO before me this 20th day of November, 1961

My commission expires 11/18/65

Joseph M. Beal  
Notary Public



15-153-3052-00-00

EXPLORATION RECORD

Lease Reeves "A"

Well 2

Formation Name	Top	Base	Remarks
Top soil and shale	0	225	
Shale and shells	225	319	
Shale	319	1500	
Shale and sand	1500	2110	
Shale and shells	2110	2265	
Shale and Sand	2265	2481	
Anhydrite	2481	2496	
Shale	2496	2660	
Shale and shells	2660	2880	
Shale	2880	3148	
Shale and Lime	3148	3418	
Lime and Shale	3418	4062	
Lime	4062	4116	
Lime and Shale	4116	4650	
Log Tops:	Howard	3838	
	Topoka	3878	
	Heebner	4007	
	Toronto	4039	
	LKC	4050	
	Base LKC	4290	
	Drum	4170	
	Marmaton	4304	
	Cherokee	4462	
	Miss.	4614	

RECEIVED  
STATE COMMISSION

NOV 21 1961

CONSERVATION DIVISION  
Wichita, Kansas

11-21-61