

This form shall be filed in duplicate with the Kansas Corporation Commission, 200 Colorado Derby Building, Wichita, Kansas 67202, within ten days after the completion of the well, regardless of how the well was completed.

Attach separate letter of request if the information is to be held confidential. If confidential, only file one copy. Information on side one will be of public record and side two will then be held confidential.

Circle one: Oil, Gas, Dry, SWD, OWWO, Injection. Type and complete ALL sections.

Applications must be filed for dual completion, commingling, SWD and injection, T.A.

Attach wireline logs (i.e. electrical log, sonic log, gamma ray neutron log, etc.). KCC # (316) 263-3238. (Rules 82-2-105 & 82-2-125)

OPERATOR F & M OIL CO., INC.

API NO. 15-039-20,592-00-00

ADDRESS 422 Union Center

COUNTY Decatur

Wichita, Kansas 67202

FIELD WC LUND

**CONTACT PERSON Preston Burkey

PROD. FORMATION Lansing

PHONE 913-483-5295

PURCHASER Koch Oil Company

LEASE Prosch

ADDRESS Box 2256

WELL NO. 1

Wichita, Kansas 67201

WELL LOCATION NE SE SE

DRILLING Abercrombie Drilling Inc.

990 Ft. from South Line and

CONTRACTOR


330 Ft. from East Line of

ADDRESS 801 Union Center

the SE/4SEC. 32 TWP. 4S RGE. 29W

Wichita, Kansas 67202

WELL PLAT

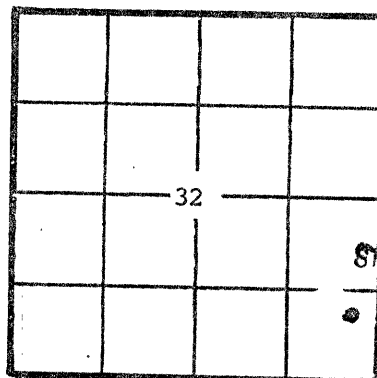

KCC [checked] KGS [checked] (Office Use)

RECEIVED STATE CORPORATION COMMISSION

RECEIVED CONSERVATION DIVISION WICHITA, KANSAS

TOTAL DEPTH 4375' PBTD -

SPUD DATE 10-28-81 DATE COMPLETED 4-4-82

ELEV: GR 2781' DF --- KB 2789'

DRILLED WITH (CABLE) (ROTARY) (AIR) TOOLS

Amount of surface pipe set and cemented 319' w/260 sxs DV Tool Used? None

AFFIDAVIT

STATE OF Kansas, COUNTY OF Sedgwick, SS, I,

R. B. Jenkins OF LAWFUL AGE, BEING FIRST DULY SWORN UPON HIS OATH,

DEPOSES THAT HE IS Vice-President Exploration (FOR)(OF) F & M OIL CO., INC.

OPERATOR OF THE Porsch LEASE, AND IS DULY AUTHORIZED TO MAKE

THIS AFFIDAVIT FOR AND ON THE BEHALF OF SAID OPERATOR, THAT WELL NO. 1 ON

SAID LEASE HAS BEEN COMPLETED AS OF THE 4th DAY OF April, 19 82

ALL INFORMATION ENTERED HEREIN WITH RESPECT TO SAID WELL IS TRUE AND CORRECT.

FURTHER AFFIANT SAITH NOT.

(S) R. B. Jenkins CONSERVATION DIVISION WICHITA, KANSAS

SUBSCRIBED AND SWORN BEFORE ME THIS 20th DAY OF April, 19 82

MY COMMISSION EXPIRES: 12-24-84

Shirley A. Gallegos - Notary Public

*The person who can be reached by phone regarding any questions concerning this information. Within ten days of completion, a witnessed initial test by the Commission is required if the well produces more than 25 BOPD or is located in a Basic Order Pool.

