


STATE OF KANSAS
STATE CORPORATION COMMISSION

WELL PLUGGING RECORD

Give All Information Completely
Make Required Affidavit
Mail or Deliver Report to
Conservation Division
State Corporation Comm.
245 North Water
Wichita, KS 67202

Cheyenne County County. Sec. 34 Twp. 4S Rge. 38W E/W
Location as "NE/CNW $\frac{1}{4}$ SW $\frac{1}{4}$ " or footage from lines _____

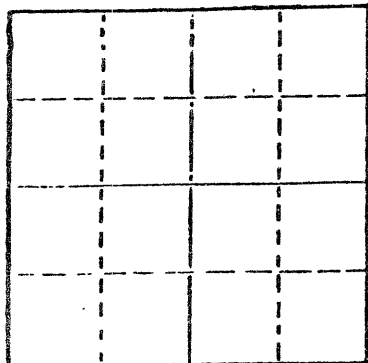

Locate well correctly on above
Section Plat

C SW NW
Lease Owner Abercrombie Drilling, Inc.
Lease Name SELVIDGE #1 Well No. #1
Office Address 801 Union Center, Wichita, KS 68202
Character of Well (Completed as Oil, Gas or Dry Hole) _____

Dry Hole
Date Well completed March 26 1981
Application for plugging filed March 26 1981
Application for plugging approved March 26 1981
Plugging commenced March 26 1981
Plugging completed March 26 1981

Reason for abandonment of well or producing formation _____
No commercial quantity of oil or gas encountered.
If a producing well is abandoned, date of last production _____ 19 _____

Was permission obtained from the Conservation Division or its agents before plugging was commenced? Yes

Name of Conservation Agent who supervised plugging of this well Gilbert Balthazar.
Producing formation _____ Depth to top _____ Bottom _____ Total Depth of Well 5200'
Show depth and thickness of all water, oil and gas formations.

OIL, GAS OR WATER RECORDS


CASING RECORD

FORMATION	CONTENT	FROM	TO	SIZE	PUT IN	PULLED OUT

Describe in detail the manner in which the well was plugged, indicating where the mud fluid was placed and the method or methods used in introducing it into the hold. If cement or other plugs were used, state the character of same and depth placed, from _____ feet to _____ feet for each plug set.

T.D. 5200'
Set 1st Plug @ 2300' with 70 sx.
Set 2nd Plug @ 400' with 20 sx.
Set 3rd Plug @ 40' Solid Bridge with 10 sx.
Rathole with 5 sx., 50-50 posmix, 6% gel.

State Plugger - Gilbert Balthazar.
Plug was down @ 12:00 noon, 3/26/81.

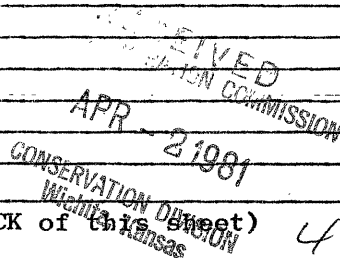

(If additional description is necessary, use BACK of _____)
Name of Plugging Contractor Abercrombie Drilling, Inc.

STATE OF Kansas COUNTY OF Sedgwick, ss.
Jack L. Partridge, Vice President (employee of owner) or (owner or operator)
of the above-described well, being first duly sworn on oath, says: That I have knowledge of the facts, statements, and matters herein contained and the log of the above-described well as filed and that the same are true and correct. So help me God.

(Signature) Jack L. Partridge
801 Union Center, Wichita, KS 67202
(Address)

SUBSCRIBED AND SWORN TO before me this 1st day of April, 19 81

My commission expires 2/4/85

Suzanne M. Hofer
Suzanne M. Hofer Notary Public.

