

15-023-00006-00-00


STATE OF KANSAS  
STATE CORPORATION COMMISSION

Give All Information Completely  
Make Required Affidavit  
Mail or Deliver Report to:  
Conservation Division  
State Corporation Commission  
211 No. Broadway  
Wichita, Kansas

WELL PLUGGING RECORD

Cheyenne County. Sec. 15 Twp. 4 Rge. 39 (E) W (W)  
Location as "NE/CNW/SW" or footage from lines CW12 NW SE  
Lease Owner Phillips Petroleum Co.  
Lease Name Boll Well No. 1  
Office Address Bartlesville, Oklahoma  
Character of Well (completed as Oil, Gas or Dry Hole) Dry Hole strat  
Date well completed Nov 9, 1958  
Application for plugging filed Nov. 9, 1958  
Application for plugging approved Nov. 9, 1958  
Plugging commenced Nov. 10, 1958  
Plugging completed Nov. 10, 1958  
Reason for abandonment of well or producing formation Dry Hole

NORTH

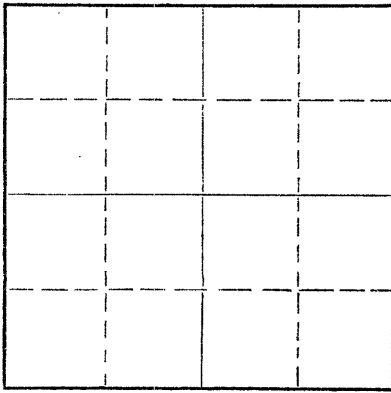

Locate well correctly on above  
Section Plat

If a producing well is abandoned, date of last production: \_\_\_\_\_ 19\_\_\_\_  
Was permission obtained from the Conservation Division or its agents before plugging was commenced? Yes

Name of Conservation Agent who supervised plugging of this well Mr. Alvin Fabricius  
Producing formation \_\_\_\_\_ Depth to top \_\_\_\_\_ Bottom \_\_\_\_\_ Total Depth of Well 5514 Feet  
Show depth and thickness of all water, oil and gas formations.

OIL, GAS OR WATER RECORDS

CASING RECORD

FORMATION	CONTENT	FROM	TO	SIZE	PUT IN	PULLED OUT
		0	345'	8 7/8"	10-16-58	No

Describe in detail the manner in which the well was plugged, indicating where the mud fluid was placed and the method or methods used in introducing it into the hole. If cement or other plugs were used, state the character of same and depth placed, from \_\_\_\_\_ feet to \_\_\_\_\_ feet for each plug set.

Pits were gunned and Heavy mud was pumped into hole.  
20 Sacks of Cement Run from 3000 ft. to 2920 ft.  
25 Sacks of Cement Run from 600 ft. to 500 ft.  
25 Sacks of Cement Run from 350 ft. to 250 ft.  
10 Sacks of Cement Run at surface.

RECEIVED  
STATE CORPORATION COMMISSION  
MAR 18 1959  
CONSERVATION DIVISION  
Wichita, Kansas

(If additional description is necessary, use BACK of this sheet)  
Name of Plugging Contractor Halliburton 3-18-59  
Address Hill City, Kan.

STATE OF Kansas, COUNTY OF Sherman, ss.  
\_\_\_\_\_  
(employee of owner) or (owner or operator) of the above-described well, being first duly sworn on oath, says: That I have knowledge of the facts, statements, and matters herein contained and the log of the above-described well as filed and that the same are true and correct. So help me God.

(Signature) J. H. Smith  
Woodland, Kan  
(Address)

SUBSCRIBED AND SWORN TO before me this 16 day of March, 19 59  
Shelma M. Knudson  
Notary Public.

My commission expires June 18 1960

PLUGGING  
FILE SEC. 15 T. 4 R. 29W  
BOOK PAGE 149 LINE 3