

15-023-20230-00-00

STATE OF KANSAS
STATE CORPORATION COMMISSION

WELL PLUGGING RECORD

Give All Information Completely
Make Required Affidavit
Mail or Deliver Report to
Conservation Division
State Corporation Comm.
245 North Water
Wichita, KS 67202

Cheyenne County, Sec. 15 Twp. 4S Rge. 40 ~~W~~
Location as "NE/CNW $\frac{1}{4}$ /SW $\frac{1}{4}$ " or footage from lines


600' ENL; 2040' FEL
Lease Owner Josephine Churchill
Lease Name Churchill Well No. 1-15

Office Address P. O. Box 15640, Lakewood, Colorado 80215
Character of Well (Completed as Oil, Gas or Dry Hole)
Dry Hole

Date Well completed March 9 1985
Application for plugging filed N/A 19
Application for plugging approved N/A 19
Plugging commenced March 9, 1985
Plugging completed March 9, 1985

Reason for abandonment of well or producing formation
Dry Hole
If a producing well is abandoned, date of last production
N/A 19

Was permission obtained from the Conservation Division or
its agents before plugging was commenced? Yes

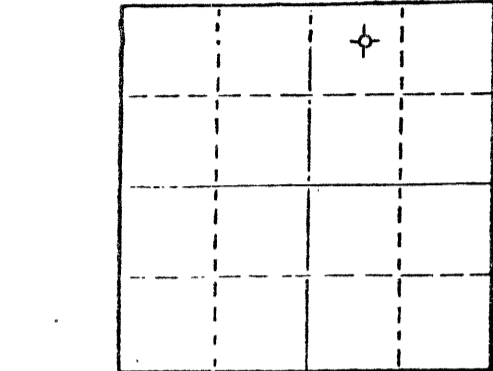

Locate well correctly on above
Section Plot

Name of Conservation Agent who supervised plugging of this well Marion Schmidt
Producing formation Niobrara Depth to top 1302' Bottom 1330' Total Depth of Well 1415'
Show depth and thickness of all water, oil and gas formations.

OIL, GAS OR WATER RECORDS No tests were run.

CASING RECORD

FORMATION	CONTENT	FROM	TO	SIZE	PUT IN	PULLED OUT
				7"	265'	0

Describe in detail the manner in which the well was plugged, indicating where the mud fluid
was placed and the method or methods used in introducing it into the hold. If cement or other
plugs were used, state the character of same and depth placed, from _____ feet to
_____ feet for each plug set.

- Plug #1 40 sacks from 1410' to 1170'
 - Plug #2 30 sacks from 280' to 130'
 - Plug #3 10 sacks from 40' to surface
- Plugs were regular cement spotted w/drill pipe.

(If additional description is necessary, use BACK of this sheet)

Name of Plugging Contractor Western Well Drilling

STATE OF Colorado COUNTY OF Jefferson, ss.

Steve P. Hoppe (employee of owner) or (owner or operator)
of the above-described well, being first duly sworn on oath, says: That I have knowledge of
the facts, statements, and matters herein contained and the log of the above-described well
as filed and that the same are true and correct. So help me God.

(Signature) Steve P. Hoppe

(Address)

SUBSCRIBED AND SWORN TO before me this 26th day of March, 19 85

My commission expires August 23, 1987

Judith Younger
Notary Public.

MAR 29 1985

3-29-85