


STATE OF KANSAS
STATE CORPORATION COMMISSION

Give All Information Completely
Make Required Affidavit
Mail or Deliver Report to:
Conservation Division
State Corporation Commission
800 Biting Building
Wichita, Kansas

NORTH

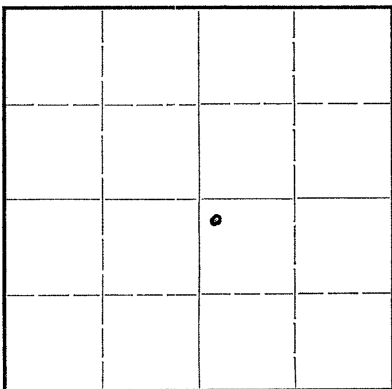

Locate well correctly on above
Section Plat

Name of Conservation Agent who supervised plugging of this well H W Kerr

Producing formation none Depth to top Bottom Total Depth of Well 4656 Feet

Show depth and thickness of all water, oil and gas formations.



OIL, GAS OR WATER RECORDS

CASING RECORD

Formation	Content	From	To	Size	Put In	Pulled Out
no record of tops of formations.				13	350'	none
well drilled under supervision of geological dept.				No material recovered.		

Describe in detail the manner in which the well was plugged, indicating where the mud fluid was placed and the method or methods used in introducing it into the hold. If cement or other plugs were used, state the character of same and depth placed, from feet to feet for each plug set.

4656' - 340' heavy mud
340' - 325' plug & 15 sx cmt
325' - 15' mud
15' - 0 cement 10 sx.

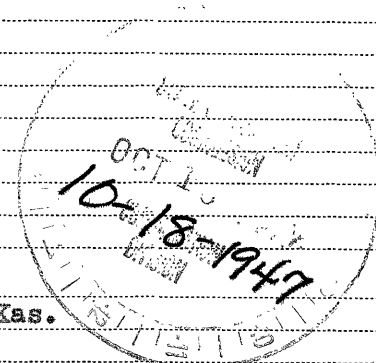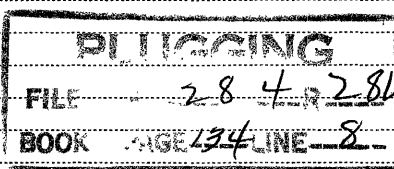

(If additional description is necessary, use BACK of this sheet)

Correspondence regarding this well should be addressed to Victor Chancellor
Address Bx 774 Great Bend, Kas.

STATE OF Kansas, COUNTY OF Barton, ss.

I, Victor Chancellor (employee of owner) or (owner or operator) of the above-described well, being first duly sworn on oath, says: That I have knowledge of the facts, statements, and matters herein contained and the log of the above-described well as filed and that the same are true and correct. So help me God.

(Signature)

Bx 774 Great Bend, Kans.

(Address)

SUBSCRIBED AND SWORN to before me this 17th day of October, 1944

My commission expires 6-14-47

Notary Public.