

15-039-20393-00-00

STATE OF KANSAS  
STATE CORPORATION COMMISSION

WELL PLUGGING RECORD

Give All Information Completely  
Make Required Affidavit  
Mail or Deliver Report to  
Conservation Division  
State Corporation Comm.  
245 North Water  
Wichita, KS 67202

Decatur County. Sec. 8 Twp. 4 S Rge. 28 ~~XX~~  
Location as "NE/CNW $\frac{1}{4}$ SW $\frac{1}{4}$ " or footage from lines  
SW SE SW


Lease Owner Gemini Corporation  
Lease Name BISHOP Well No. #2-8  
Office Address Box 818, McCook, Nebraska 69001  
Character of Well (Completed as Oil, Gas or Dry Hole)  
Dry Hole

Date Well completed July 10, 1977  
Application for plugging filed (verbally) July 10, 1977  
Application for plugging approved (verbally) July 10, 1977  
Plugging commenced July 10, 1977  
Plugging completed July 10, 1977

Reason for abandonment of well or producing formation  
No commercial quantity of oil or gas encountered.  
If a producing well is abandoned, date of last production  
19

Was permission obtained from the Conservation Division or  
its agents before plugging was commenced? Yes

Name of Conservation Agent who supervised plugging of this well Gilbert Balthazor  
Producing formation Depth to top Bottom Total Depth of Well 4100  
Show depth and thickness of all water, oil and gas formations.

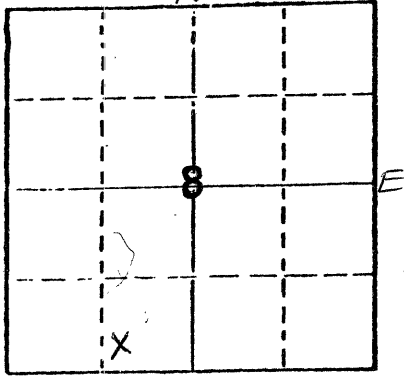

Locate well correctly on above  
Section Plat

OIL, GAS OR WATER RECORDS

CASING RECORD

FORMATION	CONTENT	FROM	TO	SIZE	PUT IN	PULLED OUT

Describe in detail the manner in which the well was plugged, indicating where the mud fluid was placed and the method or methods used in introducing it into the hold. If cement or other plugs were used, state the character of same and depth placed, from feet to feet for each plug set.

Set 1st plug at 1500' with 70 sacks  
2nd plug at 200' with 20 sacks  
3rd plug at 40' with 10 sacks

Plug was down at 9:30 a.m., July 10, 1977.

RECEIVED  
STATE CORPORATION COMMISSION  
JUL 15 1977  
07-15-1977  
CONSERVATION DIVISION  
WICHITA, KANSAS

(If additional description is necessary, use BACK of this sheet)

Name of Plugging Contractor Abercrombie Drilling, Inc.

STATE OF Kansas COUNTY OF Sedgwick, ss.  
Jack L. Partridge, Ass't. Secretary-Treasurer (employee of owner) or (owner or operator) of the above-described well, being first duly sworn on oath, says: That I have knowledge of the facts, statements, and matters herein contained and the log of the above-described well as filed and that the same are true and correct. So help me God.

(Signature) Jack L. Partridge  
801 Union Center, Wichita, Kansas 67202  
(Address)

SUBSCRIBED AND SWORN TO before me this 13th day of July, 1977

Sandra Richman  
Sandra Richman Notary Public.

My Commission Expires July 21, 1979

