


15-039-20227-00-00

STATE OF KANSAS
STATE CORPORATION COMMISSION

Form CP-4

Give All Information Completely
Make Required Affidavit
Mail or Deliver Report to:
Conservation Division
State Corporation Commission
P. O. Box 17027
Wichita, Kansas 67217
NORTH

WELL PLUGGING RECORD

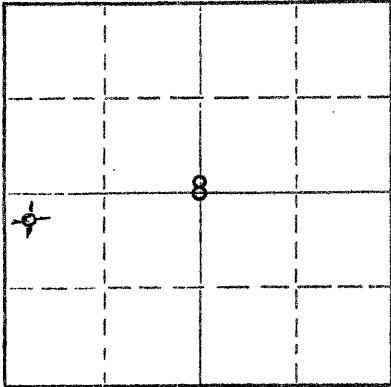

Locate well correctly on above
Section Plat

DECATUR

County, Sec. 8 Twp. 4S Rge. 28W (E) (W)

Location as "NE/CNWxSWx" or footage from lines NW NW SW

Lease Owner C-G DRILLING CO.

Lease Name BISHOP

Well No. 3

Office Address 1107 UNION NATIONAL BLDG., WICHITA KS 67202

Character of Well (completed as Oil, Gas or Dry Hole) DRY HOLE

Date well completed MARCH 20 19 72

Application for plugging filed MARCH 20 19 72

Application for plugging approved MARCH 20 19 72

Plugging commenced MARCH 20 19 72

Plugging completed MARCH 20 19 72

Reason for abandonment of well or producing formation
TOO LOW STRUCTURALLY

If a producing well is abandoned, date of last production 19

Was permission obtained from the Conservation Division or its agents before plugging was commenced? YES

Name of Conservation Agent who supervised plugging of this well W L NICHOLS P O BOX 157 MORLAND KS 67650

Producing formation _____ Depth to top _____ Bottom _____ Total Depth of Well 4130 Feet

Show depth and thickness of all water, oil and gas formations.

OIL, GAS OR WATER RECORDS

CASING RECORD

FORMATION	CONTENT	FROM	TO	SIZE	PUT IN	PULLED OUT
				8 5/8"	274.34'	NONE

Describe in detail the manner in which the well was plugged, indicating where the mud fluid was placed and the method or methods used in introducing it into the hole. If cement or other plugs were used, state the character of same and depth placed, from _____ feet to _____ feet for each plug set.

FILLED WITH HEAVY MUD TO 1675'. SET PLUG.
PUT IN 70 SACKS CEMENT. FILLED WITH HEAVY
MUD TO 310'. SET PLUG. PUT IN 80 SACKS
CEMENT. FILLED WITH HEAVY MUD TO 40'. SET
PLUG. FILLED TO TOP WITH 10 SACKS CEMENT.

RECEIVED
STATE CORPORATION COMMISSION

APR 4 - 1972
04-04-1972
CONSERVATION DIVISION
Wichita, Kansas

(If additional description is necessary, use BACK of this sheet)

Name of Plugging Contractor C-G DRILLING CO.
Address 1107 UNION NATIONAL BLDG, WICHITA, KANSAS 67202

STATE OF KANSAS COUNTY OF SEDGWICK, ss.
C-G DRILLING CO/G. F. Galloway (employee of owner) or (owner or operator) of the above-described

well, being first duly sworn on oath, says: That I have knowledge of the facts, statements, and matters herein contained and the log of the above described well as filed and that the same are true and correct. So help me God.

(Signature) G. F. Galloway
1107 Union National Bldg., Wichita, Ks.
(Address) 67202

Subscribed and sworn to before me this 24th day of March, 19 72

My commission expires Dec. 7, 1975

Phyllis Buchanan
Phyllis Buchanan
Notary Public.

