


Give All Information Completely
Make Required Affidavit
Mail or Deliver Report to:
Conservation Division
State Corporation Commission
212 No. Market
Wichita, Kansas

WELL PLUGGING RECORD

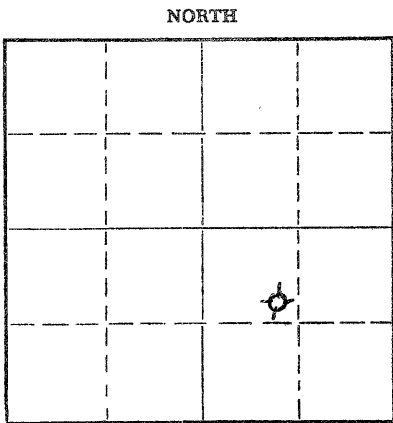

Locate well correctly on above
Section Plat

DECATUR County. Sec. 8 Twp. 4 Rge. 28 (E) W (W)
Location as "NE/CNW/SW" or footage from lines SE NW SE
Lease Owner C-G DRILLING CO.
Lease Name FRINGER #3 Well No. _____
Office Address 1107 UNION NATIONAL BUILDING, WICHITA, KANSAS
Character of Well (completed as Oil, Gas or Dry Hole) _____
Date well completed JULY 31, 1968 19____
Application for plugging filed JULY 30, 1968 19____
Application for plugging approved JULY 30, 1968 19____
Plugging commenced JULY 31, 1968 19____
Plugging completed JULY 31, 1968 19____
Reason for abandonment of well or producing formation TOO LOW STRUCTURALLY

If a producing well is abandoned, date of last production _____ 19____
Was permission obtained from the Conservation Division or its agents before plugging was commenced? YES

Name of Conservation Agent who supervised plugging of this well W. L. NICHOLS, MORELAND, KANSAS
Producing formation _____ Depth to top _____ Bottom _____ Total Depth of Well 4100 Feet
Show depth and thickness of all water, oil and gas formations.

OIL, GAS OR WATER RECORDS

CASING RECORD

FORMATION	CONTENT	FROM	TO	SIZE	PUT IN	PULLED OUT
				8-5/8"	244'	NONE

Describe in detail the manner in which the well was plugged, indicating where the mud fluid was placed and the method or methods used in introducing it into the hole. If cement or other plugs were used, state the character of same and depth placed, from _____ feet to _____ feet for each plug set.

FILLED WITH HEAVY MUD to 1680'. SET PLUG. PUT IN 100 SACKS CEMENT. FILLED WITH HEAVY MUD TO 275'. SET PLUG. PUT IN 20 SACKS CEMENT. FILLED WITH HEAVY MUD UP TO 40'. SET PLUG. FILLED TO TOP WITH 10 SACKS CEMENT.

RECEIVED
STATE CORPORATION COMMISSION
08-13-1968
AUG 13 1968
CONSERVATION DIVISION
Wichita, Kansas

(If additional description is necessary, use BACK of this sheet)
Name of Plugging Contractor C-G DRILLING COMPANY
Address 1107 UNION NATIONAL BUILDING, WICHITA, KANSAS 67202

STATE OF KANSAS, COUNTY OF SEDGWICK, ss.
G F GALLOWAY ~~(Employee of Owner)~~ or (owner or operator) of the above-described well, being first duly sworn on oath, says: That I have knowledge of the facts, statements, and matters herein contained and the log of the above-described well as filed and that the same are true and correct. So help me God.

(Signature) G F GALLOWAY
1107 UNION NATIONAL BLDG.
(Address)

SUBSCRIBED AND SWORN to before me this 5th day of AUGUST, 19 68



DEC. 7, 1971
Phyllis Buchanan
PHYLLIS BUCHANAN
Notary Public.