


Give All Information Completely  
Make Required Affidavit  
Mail or Deliver Report to:  
Conservation Division  
State Corporation Commission  
211 No. Broadway  
Wichita, Kansas

WELL PLUGGING RECORD

NORTH

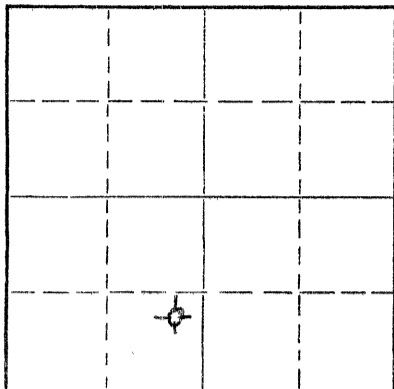

Locate well correctly on above Section Plat

DECATUR County. Sec. 8 Twp. 4 Rge. 28 (E) W (W)  
Location as "NE/CNW/SW" or footage from lines NE SE SW  
Lease Owner C-G DRILLING CO.  
Lease Name BISHOP #1 Well No.  
Office Address 107 RULE BUILDING  
Character of Well (completed as Oil, Gas or Dry Hole) DRY HOLE  
Date well completed OCT. 19, 1967 19  
Application for plugging filed OCT. 19, 1967 19  
Application for plugging approved OCT. 19, 1967 19  
Plugging commenced OCT. 19, 1967 19  
Plugging completed OCT. 19, 1967 19  
Reason for abandonment of well or producing formation TOO LOW STRUCTURALLY

If a producing well is abandoned, date of last production 19  
Was permission obtained from the Conservation Division or its agents before plugging was commenced?

Name of Conservation Agent who supervised plugging of this well W. L. NICHOLS, MORELAND, KANSAS  
Producing formation Depth to top Bottom Total Depth of Well 4160' Feet  
Show depth and thickness of all water, oil and gas formations.

OIL, GAS OR WATER RECORDS

CASING RECORD

FORMATION	CONTENT	FROM	TO	SIZE	PUT IN	PULLED OUT
				8-5/8"	243.67	NONE

Describe in detail the manner in which the well was plugged, indicating where the mud fluid was placed and the method or methods used in introducing it into the hole. If cement or other plugs were used, state the character of same and depth placed, from feet to feet for each plug set.

FILLED WITH HEAVY MUD TO 1480'.  
Set plug. PUT IN 90 SACKS CEMENT + 6% GEL. FILLED WITH HEAVY MUD TO 240'. SET PLUG. PUT IN 20 SACKS CEMENT AND 1/2 SACK HULLS. FILLED WITH HEAVY MUD UP TO 40'. SET PLUG. FILLED TO TOP WITH 1/2 SACK HULLS AND 10 SACKS CEMENT.

RECEIVED  
STATE CORPORATION COMMISSION  
NOV 7 1967  
11-07-1967  
CONSERVATION DIVISION  
Wichita, Kansas

(If additional description is necessary, use BACK of this sheet)  
Name of Plugging Contractor C-G DRILLING CO.  
Address 107 RULE BUILDING, WICHITA, KANSAS

STATE OF KANSAS, COUNTY OF SEDGWICK, ss.  
G F GALLOWAY

(Employer, owner or operator) of the above-described well, being first duly sworn on oath, says: That I have knowledge of the facts, statements, and matters herein contained and the log of the above-described well as filed and that the same are true and correct. So help me God.

(Signature) G F GALLOWAY  
107 RULE BUILDING  
(Address)

SUBSCRIBED AND SWORN TO before me this 23rd day of OCTOBER, 1967

My commission expires JAN. 23, 1968  
PHYLLIS McJIMSEY  
Notary Public.

