


STATE OF KANSAS
STATE CORPORATION COMMISSION

WELL PLUGGING RECORD

Give All Information Completely
Make Required Affidavit
Mail or Deliver Report to
Conservation Division
State Corporation Comm.
245 North Water
Wichita, KS 67202

Rawlins County. Sec. 9 Twp. 4S Rge. 34 EX/W
Location as "NE/CNW $\frac{1}{4}$ SW $\frac{1}{4}$ " or footage from lines _____

C. NE NW
Lease Owner Nielsen Enterprises, Inc.
Lease Name Simonsson Well No. #2
Office Address Suite 1380 - First of Denver Plaza, 633 Seventh
Character of Well (Completed as Oil, Gas or Dry Hole) _____

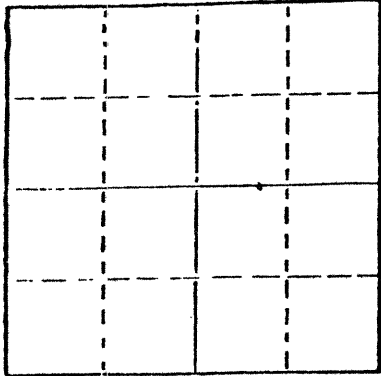

Locate well correctly on above
Section Plot

Dry Hole
Date Well completed 11-25-78 19
Application for plugging filed 11-25-78 19
Application for plugging approved 11-25-78 19
Plugging commenced 11-25-78 19
Plugging completed 11-25-78 19
Reason for abandonment of well or producing formation _____

Commerical quantities of oil not found
If a producing well is abandoned, date of last production _____ 19

Was permission obtained from the Conservation Division or its agents before plugging was commenced? Yes

Name of Conservation Agent who supervised plugging of this well Gilbert Balthazor, Palco, Ks.
Producing formation _____ Depth to top _____ Bottom _____ Total Depth of Well 4693'
Show depth and thickness of all water, oil and gas formations.

OIL, GAS OR WATER RECORDS

CASING RECORD

FORMATION	CONTENT	FROM	TO	SIZE	PUT IN	PULLED OUT
				8 5/8"	323'	None

Describe in detail the manner in which the well was plugged, indicating where the mud fluid was placed and the method or methods used in introducing it into the hold. If cement or other plugs were used, state the character of same and depth placed, from _____ feet to _____ feet for each plug set.

Plug @ 1700' w/70 sx.
Plug @ 300' w/20 sx.
Plug @ 40' w/10 sx.
Rat Hole 2 sx.

RECEIVED
STATE CORPORATION COMMISSION

DEC 15 1978

CONSERVATION DIVISION
Wichita, Kansas

(If additional description is necessary, use BACK of this sheet) 12-15-78

Name of Plugging Contractor Rains & Williamson Oil Co., Inc.

STATE OF Kansas COUNTY OF Sedgwick, ss.

Wilson Rains, President of Rains & Williamson Oil Co. Inc. (employee of owner) or (owner or operator) of the above-described well, being first duly sworn on oath, says: That I have knowledge of the facts, statements, and matters herein contained and the log of the above-described well as filed and that the same are true and correct. So help me God.

(Signature) Wilson Rains

435 Page Court, 220 W. Douglas, Wichita, Ks. 67202
(Address)

SUBSCRIBED AND SWORN TO before me this 27 day of November, 1978

My commission expires 10-4-79

Juanita M. Green Notary Public.



DRILLER'S LOG

COMPANY: Nielsen Enterprises, Inc.

SEC. 9 T. 4S R. 34W

LOC. C NE NW

WELL NAME: Simonsson #2

COUNTY: Rawlins

RIG NO. #1

TOTAL DEPTH 4693'

ELEVATION

COMMENCED: 11-12-78 COMPLETED: 11-25-78

CONTRACTOR: Rains & Williamson Oil Co., Inc.

CASING RECORD:

SURFACE: 8 5/8" @ 323' w/250 sx. 50/50 poz., 2% gel, 3% cc.

PRODUCTION: D&A

LOG

(Figures Indicate Bottom of Formations)

Shale	1600
Shale & Sand	1995
Shale	2785
Shale & Sand	2883
Shale	3035
Shale & Lime	3171
Shale	3448
Shale & Lime	4021
Lime & Shale	4400
Lime	4416
Lime & Shale	4665
Lime	4693
<u>ROTARY TOTAL DEPTH</u>	<u>4693</u>

RECEIVED
STATE CORPORATION COMMISSION

DEC 15 1978

CONSERVATION DIVISION
Wichita, Kansas

12-15-78

STATE OF Kansas)

COUNTY OF Sedgwick)

SS:

I, Wilson Rains, President of Rains & Williamson Oil Co., Inc.

upon oath state that the above and foregoing is a true and correct copy of the log of the

Simonsson #2 well.

Wilson Rains

Wilson Rains

Subscribed and sworn to before me this 27 day of November, 1978.

My Appointment Expires:

10-4-79

Juanita M. Green

Juanita M. Green

