

15-153-20254-00-00


FORM CP-4

STATE OF KANSAS  
STATE CORPORATION COMMISSION  
CONSERVATION DIVISION  
P. O. BOX 17027  
WICHITA, KANSAS 67217

WELL PLUGGING RECORD

RAWLINS County, Sec. 4 Twp. 4S Rge. 34 XXXX (W)

Location as "NE/CNW/SE/SW" or footage from lines C-SE-SW  
Lease Owner Sands-American Corp.  
Lease Name McDougal Well No. 1  
Office Address Suite 203, 5889 S. Syracuse Circle, Englewood, Colo.  
Character of Well (completed as Oil, Gas or Dry Hole) Dry Hole  
Date well completed April 12, 19 76  
Application for plugging filed April 12, 19 76  
Application for plugging approved April 12, 19 76  
Plugging commenced April 13, 19 76  
Plugging completed April 13, 19 76  
Reason for abandonment of well or producing formation Commercial quantities of oil not found.  
If a producing well is abandoned, date of last production 19  
Was permission obtained from the Conservation Division or its agents before plugging was commenced? Yes

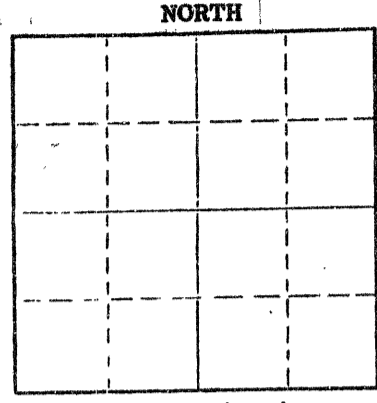

Locate well correctly on above Section Plat

Name of Conservation Agent who supervised plugging of this well Gilbert Balthazor; Palco, Kansas  
Producing formation Depth to top Bottom Total Depth of Well 4670 Feet  
Show depth and thickness of all water, oil and gas formations.

OIL, GAS OR WATER RECORDS

CASING RECORD

FORMATION	CONTENT	FROM	TO	SIZE	PUT IN	PULLED OUT
				8 5/8	370	None

Describe in detail the manner in which the well was plugged, indicating where the mud fluid was placed and the method or methods used in introducing it into the hole. If cement or other plugs were used, state the character of same and depth placed, from feet to feet for each plug set.

Drilling Mud 4670-1700 (9.7 PPG.)  
Cement-70 sacks 1700-1490  
Drilling Mud 1490- 350 (9.7 PPG.)  
Cement-20 sacks 350- 290  
Drilling Mud 290- 40 (9.7 PPG.)  
Cement-10 sacks 40- 0  
Cemented Rat Hole  
Mud and Cement Placed thru Drill Pipe

RECEIVED  
CONSERVATION DIVISION  
WICHITA, KANSAS  
APR 27 1976

(If additional description is necessary, use BACK of this sheet)  
Name of Plugging Contractor HALLIBURTON CO.  
Address Oberlin, Kansas

STATE OF COLORADO COUNTY OF DENVER  
THOMAS M. CARROLL (employee of owner) of the above-described

well, being first duly sworn on oath, says: That I have knowledge of the facts, statements, and matters herein contained and the log of the above-described well as filed and that the same are true and correct. So help me God.

(Signature) Thomas M. Carroll  
415 Petroleum Club Building  
(Address)

SUBSCRIBED AND SWORN TO before me this 23rd day of April, 1976.

My Commission expires July 19, 1977  
Notary Public.