


All Information Completely
Required Affidavit
or Deliver Report to:
Conservation Division
State Corporation Commission
211 No. Broadway
Wichita, Kansas

WELL PLUGGING RECORD

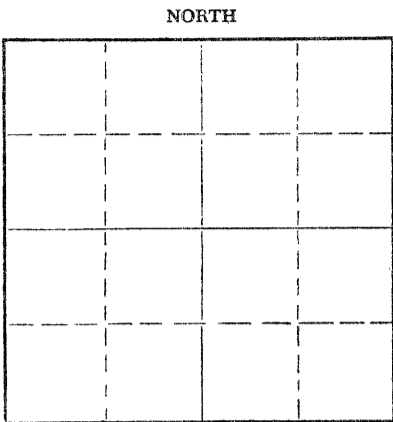

Locate well correctly on above
Section Plat

Cheyenne County, Sec. 36 Twp. ~~43S~~^{4S} Rge. 37W (E) (W)
Location as "NE/CNW/SW" or footage from lines C NW NE
Lease Owner Toto Gas Company & Arvel C. Smith
Lease Name ~~Dubin~~ Reuber Well No. 1
Office Address Box 7400 Oklahoma City 12, Okla.
Character of Well (completed as Oil, Gas or Dry Hole) Oil
Date well completed July 11, 19 62
Application for plugging filed January 25, 19 63
Application for plugging approved January 28, 19 63
Plugging commenced March 11, 1963 19
Plugging completed April 4, 1963 19
Reason for abandonment of well or producing formation Dry

If a producing well is abandoned, date of last production _____ 19____
Was permission obtained from the Conservation Division or its agents before plugging was com-
menced? Yes

Name of Conservation Agent who supervised plugging of this well W. L. Nichols
Producing formation _____ Depth to top _____ Bottom _____ Total Depth of Well 4527 Feet
Show depth and thickness of all water, oil and gas formations.

OIL, GAS OR WATER RECORDS

CASING RECORD

FORMATION	CONTENT	FROM	TO	SIZE	PUT IN	PULLED OUT
				8 5/8	304	none
				4 1/2	none	20 1/1

Describe in detail the manner in which the well was plugged, indicating where the mud fluid was placed and the method or methods used in introducing it into the hole. If cement or other plugs were used, state the character of same and depth placed, from _____ feet to _____ feet for each plug set.

Moved on and cleaned out cellar, sanded to 4430' and dumped 4 sx. cement. Worked pipe.
Snowed so shut down
Worked pipe and shot @ 4000'-3500'-3000'-2500'. Loaded hole with water.
Worked pipe and shot @ 2400'-2300'-2200'-2100'-2030'. Started pulling pipe.
Mixed and pumped 35 sx mud and 20 sx, cement @ 600'. Pulled pipe and pumped 20 sx. cement @ 300'. Pulled pipe and capped well with 10 sx. cement.

RECEIVED
STATE CORPORATION COMMISSION

APR 12 1963

4-12-63
CONSERVATION DIVISION
Wichita, Kansas

(If additional description is necessary, use BACK of this sheet)
Name of Plugging Contractor Forbes Casing Pulling, Inc.
Address Box 221 Great Bend, Kansas

STATE OF Kansas, COUNTY OF Barton, ss.
J. O. Forbes (employee of owner) or (owner or operator) of the above-described well, being first duly sworn on oath, says: That I have knowledge of the facts, statements, and matters herein contained and the log of the above-described well as filed and that the same are true and correct. So help me God.

(Signature) J. O. Forbes
Box 221 Great Bend, Kansas
(Address)

SUBSCRIBED AND SWORN TO before me this 5th day of April, 1963

My commission expires July 23, 1966

Carolyn Herren
Notary Public.

