


STATE OF KANSAS  
STATE CORPORATION COMMISSION

WELL PLUGGING RECORD

Give All Information Completely  
Make Required Affidavit  
Mail or Deliver Report to  
Conservation Division  
State Corporation Comm.  
245 North Water  
Wichita, KS 67202

Cheyenne County, Sec. 25 Twp. 4S Rge. 37 NE/W  
Location as "NE/CNW $\frac{1}{4}$ SW $\frac{1}{4}$ " or footage from lines  
25' W & 25' N C NW SW

Lease Owner Abraxas Petroleum Corporation  
Lease Name Daisy Miller Well No. #1  
Office Address P. O. Box 17485, San Antonio, Tex. 78217  
Character of Well (Completed as Oil, Gas or Dry Hole) Dry Hole

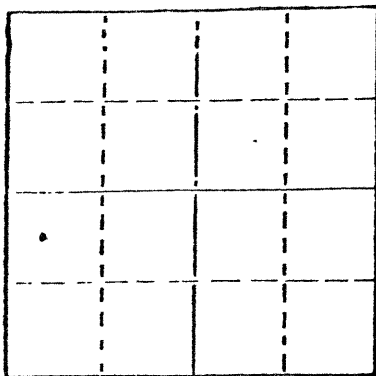

Locate well correctly on above  
Section Plat

Date Well completed 9-22-80 19  
Application for plugging filed 9-22-80 19  
Application for plugging approved 9-22-80 19  
Plugging commenced 9-22-80 19  
Plugging completed 9-22-80 19  
Reason for abandonment of well or producing formation  
Commercial quantities of oil not found  
If a producing well is abandoned, date of last production  
19

Was permission obtained from the Conservation Division or  
its agents before plugging was commenced? Yes

Name of Conservation Agent who supervised plugging of this well Gilbert Balthazor  
Producing formation \_\_\_\_\_ Depth to top \_\_\_\_\_ Bottom \_\_\_\_\_ Total Depth of Well 4800'  
Show depth and thickness of all water, oil and gas formations.

OIL, GAS OR WATER RECORDS

CASING RECORD

FORMATION	CONTENT	FROM	TO	SIZE	PUT IN	PULLED OUT
				8 5/8"	367'	None

Describe in detail the manner in which the well was plugged, indicating where the mud fluid  
was placed and the method or methods used in introducing it into the hold. If cement or other  
plugs were used, state the character of same and depth placed, from \_\_\_\_\_ feet to  
\_\_\_\_\_ feet for each plug set.

Plug @ 2000' w/70 sx.

Plug @ 300' w/40 sx.

Plug @ 40' w/10 sx.

Rat Hole 5 sx.

RECEIVED

STATE CORPORATION COMMISSION

OCT - 6 1980

CONSERVATION DIVISION  
Wichita, Kansas

(If additional description is necessary, use BACK of this sheet)

Name of Plugging Contractor Rains & Williamson Oil Co., Inc.

STATE OF Kansas COUNTY OF Sedgwick, ss.

Wilson Rains, President of Rains & Williamson Oil Co., Inc. (employee of owner) or (owner or operator)  
of the above-described well, being first duly sworn on oath, says: That I have knowledge of  
the facts, statements, and matters herein contained and the log of the above-described well  
as filed and that the same are true and correct. So help me God.

(Signature) Wilson Rains

435 Page Court, 220 W. Douglas, Wichita, Ks. 67202  
(Address)

SUBSCRIBED AND SWORN TO before me this 24 day of September, 1980

My commission expires 10-4-83

Juanita M. Green Notary Public.



15-023-20152-00-00

DRILLER'S LOG

COMPANY: Abraxas Petroleum Corporation

SEC. 25 T. 4S R. 37W

LOC. 25' W & 25' N C NW SW

WELL NAME: Daisy Miller #1

COUNTY: Cheyenne

RIG NO. #1

TOTAL DEPTH 4800'

ELEVATION 3,383' G.L.  
3,391' K.B.

COMMENCED: 9-11-80

COMPLETED: 9-22-80

CONTRACTOR: Rains & Williamson Oil Co., Inc.

CASING RECORD:

SURFACE: 8 5/8" @ 367' w/325 sx. 50/50 poz., 3% cc., 2% gel.

PRODUCTION: D&A

LOG

(Figures Indicate Bottom of Formations)

Clay & Sand	330
Shale	2050
Shale & Lime	2455
Shale	2991
Shale & Sand	3702
Shale	3939
Shale & Lime	4060
Lime	4580
Shale & Lime	4760
Shale & Sand	4800
<u>ROTARY TOTAL DEPTH</u>	<u>4800</u>

RECEIVED  
STATE CORPORATION COMMISSION

OCT - 6 1980

CONSERVATION DIVISION  
Wichita, Kansas

STATE OF Kansas )  
COUNTY OF Sedgwick ) SS:

I, Wilson Rains, President of Rains & Williamson Oil Co., Inc.  
upon oath state that the above and foregoing is a true and correct copy of the log of the  
Daisy Miller #1 well.

Wilson Rains  
Wilson Rains

Subscribed and sworn to before me this 24 day of September, 1980.

Juanita M. Green  
Juanita M. Green



My Appointment Expires:  
10-4-83