

STATE OF KANSAS  
STATE CORPORATION COMMISSION

WELL PLUGGING RECORD

Give All Information Completely  
Take Required Affidavit  
Mail or Deliver Report to  
Conservation Division  
State Corporation Comm.  
245 North Water  
Wichita, KS 67202

Cheyenne County, Sec. 25 Twp. 4S Rge. 37 N/W  
Location as "NE/CNW1SW1" or footage from lines  
330 FNL 990 FEL

Lease Owner Cities Service Company

Lease Name Gibson "C" Well No. #1

Office Address 209 East William Wichita, KS 67202

Character of Well (Completed as Oil, Gas or Dry Hole)  
Gas

Date Well completed December 11, 1978

Application for plugging filed June 11, 1979

Application for plugging approved June 12, 1979

Plugging commenced August 9, 1979

Plugging completed August 9, 1979

Reason for abandonment of well or producing formation

Not economical to produce

If a producing well is abandoned, date of last production

Shut in gas well 19


Was permission obtained from the Conservation Division or

its agents before plugging was commenced? Yes

Name of Conservation Agent who supervised plugging of this well Gilbert Balthazer

Producing formation Niobrara Depth to top 1166 Bottom 1176 Total Depth of Well 4763'

How depth and thickness of all water, oil and gas formations.

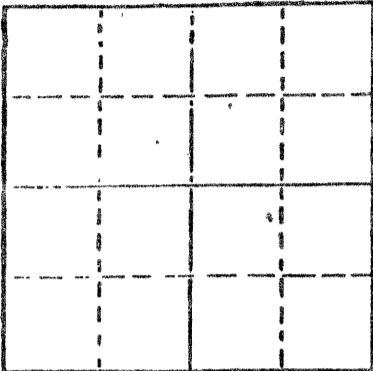

Locate well correctly on above  
Section Plot

OIL, GAS OR WATER RECORDS

CASING RECORD

FORMATION	CONTENT	FROM	TO	SIZE	PUT IN	PULLED OUT
				8 5/8"	376'	-0-
				4 1/2"	1264'	-0-

Describe in detail the manner in which the well was plugged, indicating where the mud fluid  
was placed and the method or methods used in introducing it into the hold. If cement or other  
plugs were used, state the character of same and depth placed, from \_\_\_\_\_ feet to  
\_\_\_\_\_ feet for each plug set.

Pumped into 4 1/2 casing one sack hulls, 50 sacks 50-50 Pozmix  
plus 6% gel. Filled to surface. Complete at 11:00 a.m. 8/9/79.

(If additional description is necessary, use BACK of this sheet)

Name of Plugging Contractor Halliburton Cementing Company

Stamp: STATE CORPORATION COMMISSION  
August 11 1979  
8-17-79

STATE OF Kansas COUNTY OF Sedgwick  
E. W. Peterman (employee of owner) or owner or operator

I, the above-described well, being first duly sworn on oath, says: That I have knowledge of  
the facts, statements, and matters herein contained and the log of the above-described well  
is filed and that the same are true and correct. So help me God.

(Signature) E. W. Peterman E. W. Peterman  
209 East William, Wichita, Kansas 67202

(Address)

SUBSCRIBED AND SWORN TO before me this 16 day of May, 19

Dean Caldwell Notary Public.

My commission expires 10-16-81

