

CARD MUST BE TYPED

State of Kansas  
**NOTICE OF INTENTION TO DRILL**  
(see rules on reverse side)

CARD MUST BE SIGNED

15-153-20585-00-01

Starting Date: 2 11 85  
month day year

API Number 15-

153-20,585-00-01

**OPERATOR:** License # 5420  
Name White & Ellis Drilling, Inc.  
Address 401 E. Douglas - Suite 500  
City/State/Zip Wichita, Ks. 67202  
Contact Person Howard Russell  
Phone 316-321-5050

C NE NE Sec 6 Twp 4 S, Rge 36  
(location)  
4620  
660  
Ft North from Southeast Corner of Section  
Ft West from Southeast Corner of Section  
(Note: Locate well on Section Plat on reverse side)

East  
 West

**CONTRACTOR:** License # 8301  
Name Stoepelwerth Drilling, Inc.  
City/State McCook, Neb. 69001

Nearest lease or unit boundary line 660 feet.  
County Rawlins  
Lease Name Wahrman Well# 1

Domestic well within 330 feet:  yes  no  
Municipal well within one mile:  yes  no

**Well Drilled For:** Well Class: Type Equipment:  
 Oil  Swd  Infield  Mud Rotary  
 Gas  Inj  Pool Ext.  Air Rotary  
 OWWO  Expl  Wildcat  Cable

Depth to Bottom of fresh water 270 feet  
Lowest usable water formation ~~consolidated~~  
Depth to Bottom of usable water 320 feet  
Surface pipe by Alternate: 1  343   
Surface pipe to be set  
Conductor pipe if any required 3150 feet  
Ground surface elevation 3150 feet MSL  
This Authorization Expires 8-5-85  
Approved By 2-5-85

If OWWO: old well info as follows:

Operator Stoepelwerth Drilling, Inc.  
Well Name Wahrman #6-41  
Comp Date 12-29-84 Old Total Depth 4768'  
Projected Total Depth 4850' feet  
Projected Formation at TD Mississippi  
Expected Producing Formations Cher.-Miss.

I certify that we will comply with K.S.A. 55-101, et seq., plus eventually plugging hole to K.C.C. specifications.

Date 2-5-85 Signature of Operator or Agent


Ernest Siford

Title White & Ellis - Sec.-Treas.

Must be filed with the K.C.C. five (5) days prior to commencing well  
 This card void if drilling not started within six (6) months of date received by K.C.C.

**Important procedures to follow :**

**A Regular Section of Land**  
**1 Mile = 5,280 Ft.**

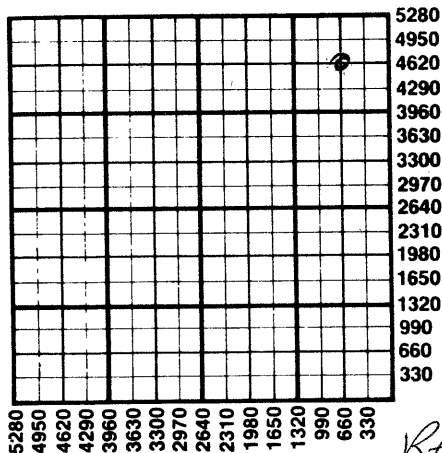

1. Notify District office before setting surface casing.
2. Set surface casing by circulating cement to the top.
3. File completion forms ACO-1 with K.C.C. within 90 days of well completion, following instructions on ACO-1, side 1, and including copies of wireline logs.
4. Notify District office 48 hours prior to old well workover or re-entry.
5. Prior to plugging, prepare a plugging plan and obtain agreement from the appropriate district office for an approved plugging plan.
6. Submit plugging report (AC-4) to K.C.C. after plugging is completed.
7. Obtain an approved injection document before disposing of salt water.
8. Notify K.C.C. within 10 days when injection commences or terminates.
9. If an alternate 2 completion, cement in the production pipe from below any usable water to surface within 120 days of spud date.

*Rec'd*  
*2-5-85*

**State Corporation Commission of Kansas**  
**Conservation Division**  
**200 Colorado Derby Building**  
**Wichita, Kansas 67202**  
**(316) 263-3238**