

CARD MUST BE TYPED

State of Kansas
NOTICE OF INTENTION TO DRILL
(see rules on reverse side)

CARD MUST BE SIGNED

Starting Date: December 5, 1984
month day year

API Number 15- 153-20,585-00-00

OPERATOR: License # 8301
Name Stoeppelwerth Drilg & ~~INC~~
Address P.O. Box 978
City/State/Zip McCook, Ne. 69001-0978
Contact Person Jack Lowry
Phone 308-345-1766/308-345-6655 (Mobile)

NE NE (location) Sec 6 Twp 4 S, Rge 36 XX West
4620 Ft North from Southeast Corner of Section
660 Ft West from Southeast Corner of Section
(Note: Locate well on Section Plat on reverse side)

CONTRACTOR: License # 8301
Name Stoeppelwerth Drilg
City/State McCook, Ne.

Nearest lease or unit boundary line 660 feet.
County Rawlins
Lease Name Wahman Well# 6-41
Domestic well within 330 feet: yes no
Municipal well within one mile: yes no

Well Drilled For: Well Class: Type Equipment:
 Oil Swd Infield Mud Rotary
 Gas Inj Pool Ext. Air Rotary
 OWWO Expl Wildcat Cable

Depth to Bottom of fresh water 270 feet
Lowest usable water formation Ogatahah
Depth to Bottom of usable water 270-320 feet
Surface pipe by Alternate: 1XX 2
Surface pipe to be set 320 feet
Conductor pipe if any required
Ground surface elevation 3150 feet MSL
This Authorization Expires 5-30-85
Approved By 11-30-84

If OWWO: old well info as follows:

Operator
Well Name
Comp Date Old Total Depth
Projected Total Depth 5000 feet
Projected Formation at TD Mississippiian
Expected Producing Formations Cherokee/Lansing

I certify that we will comply with K.S.A. 55-101, et seq., plus eventually plugging hole to K.C.C. specifications.

Date 11-30-84 Signature of Operator or Agent Susan Arnold Title as agent

Form C-1 4/84

MHC/KOHE 11/30/84


Must be filed with the K.C.C. five (5) days prior to commencing well
This card void if drilling not started within six (6) months of date received by K.C.C.

Wichita, Kansas
CONSERVATION DIVISION

NOV 30 1984

11-30-84

A Regular Section of Land
OWNERS

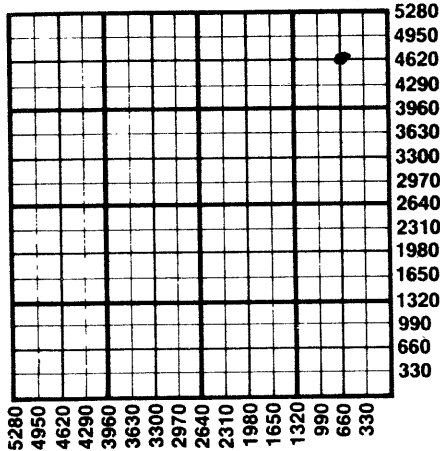

Important procedures to follow :

1. Notify District office before setting surface casing.
2. Set surface casing by circulating cement to the top.
3. File completion forms ACO-1 with K.C.C. within 90 days of well completion, following instructions on ACO-1, side 1, and including copies of wireline logs.
4. Notify District office 48 hours prior to old well workover or re-entry.
5. Prior to plugging, prepare a plugging plan, then obtain agreement from the appropriate district office for an approved plugging plan.
6. Submit plugging report (CP-4) to K.C.C. after plugging is completed.
7. Obtain an approved injection docket number before disposing of salt water.
8. Notify K.C.C. within 10 days when injection commences or terminates.
9. If an alternate 2 completion, cement in the production pipe from below any usable water to surface within 120 days of spud date.

State Corporation Commission of Kansas
Conservation Division
200 Colorado Derby Building
Wichita, Kansas 67202
(316) 263-3238