

CARD MUST BE TYPED

State of Kansas

CARD MUST BE SIGNED

NOTICE OF INTENTION TO DRILL

(see rules on reverse side)

Expected Spud Date..... month day year

API Number 15— 147-20, 506-00-00 *DA*

OPERATOR: License # 5393

..... NE NE SW Sec... 30 Twp. 5 S, Rg... 17 X East X West

Name A.L. Abercrombie, Inc.

..... 2310! FSL..... Ft. from South Line of Section

Address 801 Union Center

..... 2970! FEL..... Ft. from East Line of Section

City/State/Zip Wichita, Ks. 67202

(Note: Locate well on Section Plat on reverse side)

Contact Person Jack L. Partridge

Nearest lease or unit boundary line 330..... feet

Phone 262-1841

County Phillips Co., Ks.

CONTRACTOR: License # 5422

Lease Name Hahn Well # B.#1

Name Abercrombie Drilling, Inc.

Ground surface elevation feet MSL

City/State Wichita, Ks. 67202

Domestic well within 330 feet: yes X no

Well Drilled For: Well Class: Type Equipment:

Municipal well within one mile: yes X no

X Oil Storage Infield X Mud Rotary

Depth to bottom of fresh water... 100!

 Gas Inj Pool Ext. Air Rotary

Depth to bottom of usable water .. 850. Dakota

 OWWO Expl X Wildcat Cable

Surface pipe by Alternate: 1 X 2

If OWWO: old well info as follows:

Surface pipe planned to be set 210!

Operator

Conductor pipe required ... None

Well Name N/A

Projected Total Depth . 3500..... feet

Comp Date Old Total Depth.....

Formation Arbuckle

I certify that well will comply with K.S.A. 55-101, et seq., plus eventually plugging hole to KCC specifications.

Date Signature of Operator or Agent Jack L. Partridge Title Vice President

For KCC Use:

Conductor Pipe Required feet; Minimum Surface Pipe Required 200 feet per Alt. X 2

This Authorization Expires 11-10-88 Approved By 570-88


EFFECTIVE DATE: 5-15-88

Must be filed with the K.C.C. five (5) days prior to commencing well
 This card void if drilling not started within six (6) months of date received by K.C.C.

Important procedures to follow:

1. Notify District office before setting surface casing.
2. Set surface casing by circulating cement to the top.
3. File completion forms ACO-1 with K.C.C. within 120 days of well spud date, following instructions on ACO-1, side 1, and including copies of wireline logs.
4. Notify District office 48 hours prior to old well workover or re-entry.
5. Prior to filing Intent, prepare a proposed plugging plan in case well is D & A, then obtain approval of plan when calling district office prior to setting surface pipe.
6. Submit plugging report (CP-4) to K.C.C. after plugging is completed.
7. Obtain an approved injection docket number before disposing of salt water.
8. Notify K.C.C. within 10 days when injection commences or terminates.

**A Regular Section of Land
 1 Mile = 5,280 Ft.**

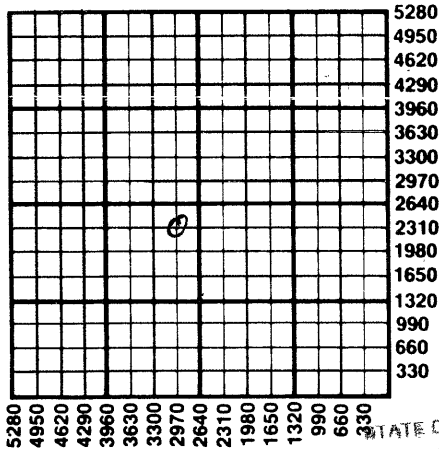

RECEIVED
 STATE CORPORATION COMMISSION

MAY 10 1988
 5-10-88
 CONSERVATION DIVISION
 Wichita, Kansas

9. If an alternate 2 completion, cement in the production pipe from below any usable water to surface within 120 days of spud date.

State Corporation Commission of Kansas
 Conservation Division
 200 Colorado Derby Building
 Wichita, Kansas 67202-1212
 (316) 263-3238