

15-039-20335-00-00


FORM CP-4

STATE OF KANSAS  
STATE CORPORATION COMMISSION  
CONSERVATION DIVISION  
P. O. BOX 17027  
WICHITA, KANSAS 67217

WELL PLUGGING RECORD

Decatur County, Sec. 5 Twp. 4S Rge. 28 (W)

Location as "NE/CNW/SW" or footage from lines: C NE NE NE  
Lease Owner: S & W Drilling Co., Inc.  
Lease Name: SMICK Well No. #1  
Office Address: Box 132 Oberlin, Kansas  
Character of Well (completed as Oil, Gas or Dry Hole): Dry Hole  
Date well completed: May 18, 1976  
Application for plugging filed (verbally): May 18, 1976  
Application for plugging approved (verbally): May 18, 1976  
Plugging commenced: May 18, 1976  
Plugging completed: May 18, 1976  
Reason for abandonment of well or producing formation: No commercial quantity of oil or gas encountered.  
If a producing well is abandoned, date of last production: 19  
Was permission obtained from the Conservation Division or its agents before plugging was commenced? Yes

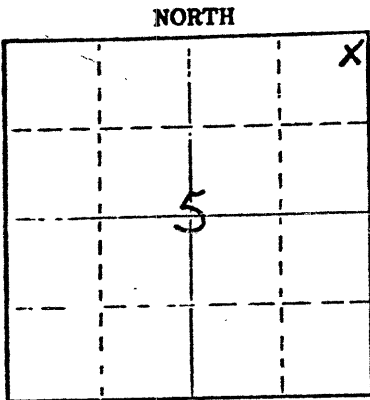

Locate well correctly on above Section Plat

Name of Conservation Agent who supervised plugging of this well: Gilbert Balthazor  
Producing formation: \_\_\_\_\_ Depth to top: \_\_\_\_\_ Bottom: \_\_\_\_\_ Total Depth of Well: 3085'  
Show depth and thickness of all water, oil and gas formations.

OIL, GAS OR WATER RECORDS

FORMATION	CONTENT	FROM	TO	SIZE	PUT IN	PULLED OUT
				8 5/8"	264.85'	none

CASING RECORD

Describe in detail the manner in which the well was plugged, indicating where the mud fluid was placed and the method or methods used in introducing it into the hole. If cement or other plugs were used, state the character of same and depth placed, from \_\_\_\_\_ feet to \_\_\_\_\_ feet for each plug set.

1st Plug was Set @ 1200' with 70 sx. cement  
2nd Plug was Set @ 250' with 20 sx. cement  
3rd Plug was Set @ 40' with 10 sx. cement  
Plug was down @ 8:00 p.m. May 18, 1976

Name of Plugging Contractor: Abercrombie Drilling, Inc  
Address: 801 Union Center, Wichita, Kansas 67202  
Date: 06-17-1976

STATE OF KANSAS COUNTY OF SEDGWICK ss.  
Jerry A. Langrehr-Exec. Vice President (employee of owner) or (owner or operator) of the above-described well, being first duly sworn on oath, says: That I have knowledge of the facts, statements, and matters herein contained and the log of the above-described well as filed and that the same are true and correct. So help me God.

(Signature) Jerry A. Langrehr  
801 Union Center, Wichita, Kansas 67202 (Address)

Subscribed and sworn to before me this 21st day of May, 1976

My commission expires February 18, 1980  
Diane Steincamp Notary Public

