


15-089-00003-0600

STATE OF KANSAS
STATE CORPORATION COMMISSION

WELL PLUGGING RECORD

Give All Information Completely
Make Required Affidavit
Mail or Deliver Report to:
Conservation Division
State Corporation Commission
800 Bitting Building
Wichita, Kansas

NORTH

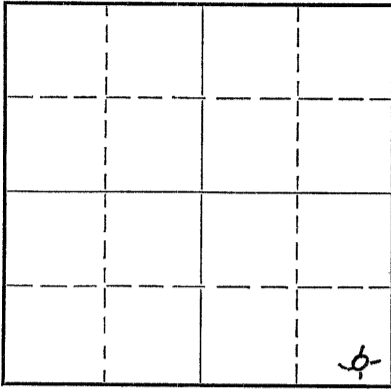

Locate well correctly on above
Section Plat

Jewel County. Sec. 11 Twp 5S Rge 10W (E) (W)
Location as "NE/CNW $\frac{1}{4}$ SW $\frac{1}{4}$ " or footage from lines SE SE
Lease Owner A. D. Allison et al
Lease Name DeBeys Well No. 1
Office Address 715 Brown Building, Wichita, Kansas
Character of Well (completed as Oil, Gas or Dry Hole) Dry Hole
Date well completed 9-8-1950
Application for plugging filed 9-8-1950
Application for plugging approved 9-8-1950
Plugging commenced 9-8-1950
Plugging completed 9-8-1950
Reason for abandonment of well or producing formation Dry hole

If a producing well is abandoned, date of last production 19
Was permission obtained from the Conservation Division or its agents before plugging was commenced? Yes

Name of Conservation Agent who supervised plugging of this well Ruel Durkee
Producing formation Depth to top Bottom Total Depth of Well 4204 Feet
Show depth and thickness of all water, oil and gas formations.

OIL, GAS OR WATER RECORDS

CASING RECORD

Formation	Content	From	To	Size	Put In	Pulled Out
Lime	Water	40	80	12 $\frac{1}{2}$	80	0

Describe in detail the manner in which the well was plugged, indicating where the mud fluid was placed and the method or methods used in introducing it into the hole. If cement or other plugs were used, state the character of same and depth placed, from feet to feet for each plug set.

Loaded hole with mud. Bottom plug at 80'. 25 sacks cement poured through drill pipe. Top plug at 25' and 15 sacks cement to surface.

RECEIVED
STATE CORPORATION COMMISSION
SEP 25 1950
CONSERVATION DIVISION
Wichita, Kansas

9-25-50

(If additional description is necessary, use BACK of this sheet)

Correspondence regarding this well should be addressed to A. D. Allison & Co., Inc.,
Address 715 Brown Building, Wichita 2, Kansas.

STATE OF Kansas, COUNTY OF Sedgwick, ss.
J. A. Allison (employee of owner) or (owner or operator) of the above-described well,
being first duly sworn on oath, says: That I have knowledge of the facts, statements, and matters herein contained and the log of the above-described well as filed and that the same are true and correct. So help me God

(Signature) J. A. Allison
715 Brown Bldg., Wichita 2, Kansas.
(Address)

SUBSCRIBED AND SWORN to before me this 22nd day of September, 1950.

Ruel Schock
Notary Public.

My commission expires 7-22-53

28-3278-s 4-50-10M

