


15-183-20005-00-00

STATE OF KANSAS
STATE CORPORATION COMMISSION

Form CP-4

WELL PLUGGING RECORD

Give All Information Completely
Make Required Affidavit
Mail or Deliver Report to:
Conservation Division
State Corporation Commission
P. O. Box 17027
Wichita, Kansas 67217
NORTH

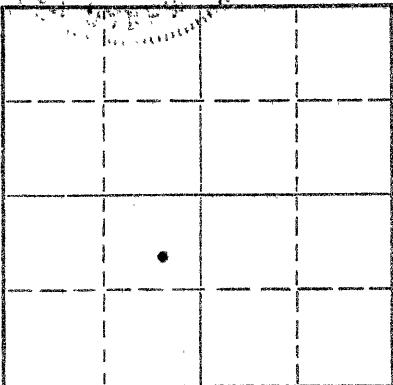

Locate well correctly on above
Section Plat

SMITH County, Sec. 5 Twp. 5 Rge. (E) 11 (W)
Location as "NE/CNWASW" or footage from lines. CS2-NE-5W
Lease Owner CLOUD EXPLORATION
Lease Name OLIVER Well No. 1
Office Address 231 W. 20th, CONCORDIA, KANSAS 66901
Character of Well (completed as Oil, Gas or Dry Hole) DRY HOLE
Date well completed 2-16 1972
Application for plugging filed 2-16 1972
Application for plugging approved _____ 19____
Plugging commenced 12.01 AM 2-17 1972
Plugging completed 1.30 AM 2-17 1972
Reason for abandonment of well or producing formation NO SHOWS OF ANY OIL

If a producing well is abandoned, date of last production _____ 19____
Was permission obtained from the Conservation Division or its agents before plugging was commenced? YES

Name of Conservation Agent who supervised plugging of this well DON TRUAN
Producing formation TARKIO To ARBUCKLE Depth to top _____ Bottom _____ Total Depth of Well 4190 Feet
Show depth and thickness of all water, oil and gas formations. NO SHOW OF OIL

OIL, GAS OR WATER RECORDS

CASING RECORD

FORMATION	CONTENT	FROM	TO	SIZE	PUT IN	PULLED OUT
<u>CLAY-SHALE</u>		<u>0</u>	<u>235'</u>	<u>8 5/8</u>	<u>235'</u>	<u>NONE</u>

Describe in detail the manner in which the well was plugged, indicating where the mud fluid was placed and the method or methods used in introducing it into the hole. If cement or other plugs were used, state the character of same and depth placed, from _____ feet to _____ feet for each plug set.

ALLIED CEMENTING Co. RUSSELL, KANSAS
Cementary DUG SELLERS
HELPER B. MEADCO

Method PUMP TRUCK

PLUGS 600' W/ 50 SXS
210' W/ 25 SXS
40' W/ 10 SXS
Rat HOLE 2 SXS

RECEIVED
STATE CORPORATION COMMISSION
FEB 29 1972
CONSERVATION DIVISION
Wichita, Kansas

2-29-72

(If additional description is necessary, use BACK of this sheet)

Name of Plugging Contractor EHRlich DRILLING Co.
Address WILSON, KANSAS

STATE OF Kansas, COUNTY OF Cloud, ss.
Arnold A. Schaefer (employee of owner) or (owner or operator) of the above-described well, being first duly sworn on oath, says: That I have knowledge of the facts, statements, and matters herein contained and the log of the above-described well as filed and that the same are true and correct. So help me God.

(Signature) Arnold A. Schaefer
231 W 20th Concordia Kan-
(Address)

WITNESSED and SUBSCRIBED before me this 9th day of February, 1972
December 12, 1972
Judy Baker
Notary Public.

