

15-147-20367-00-00


STATE OF KANSAS
STATE CORPORATION COMMISSION
200 Colorado Derby Bldg.
Wichita, Kansas 67202

Form CP-4
Rev. 12-15-80

WELL PLUGGING RECORD

Give All Information Completely
Make Required Affidavit

COUNTY Phillips SEC. 9 TWP. 5S RGE. 17 E/W
Location as in quarters or footage from lines:
SE SW SW

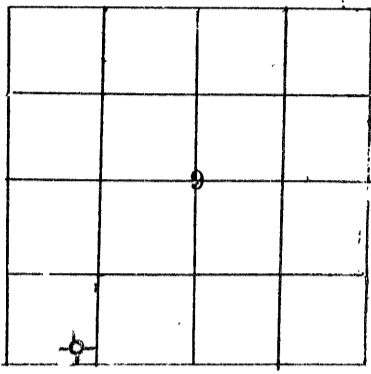

Locate Well
correctly on above
Section Platt.

Lease Owner Rupe Oil Company, Inc.
Lease Name Wheaton Well No. 1
Office Address P.O. Box 2273, 434 Ohio Wichita, KS 67201
Character of Well (Completed as Oil, Gas or Dry Hole): Dry Hole
Date Well Completed November 27, 1981
Application for plugging filed Verbally, November 26, 1981
Plugging commenced 7:00 p.m. November 26, 1981
Plugging completed 3:00 a.m. November 27, 1981
Reason for abandonment of well or producing formation Dry Hole

Was permission obtained from the Conservation Division or it's
Agent's before plugging was commenced? Yes

Name of Conservation Agent who supervised plugging of this well Gilbert Scheck

Producing formation N/A Depth to top N/A bottom N/A T.D. N/A

Show depth and thickness of all water, oil and gas formations.

OIL, GAS OR WATER RECORDS

Casing Record

Formation	Content	From	To	Size	Put in	Pulled Out
				8 5/8" 20#	240'	None

Describe in detail the manner in which the well was plugged, indicating where the mud fluid was placed and the method or methods used in introducing it into the hold. If cement or other plugs were used, state the character of same and depth placed, from _____ feet to _____ feet for each plug set.

Plugged with 130 sacks 50/50 Pozmix (4% gel, 3% CaCl)

- Set 1st Plug @ 840' w/70 sacks
- Set 2nd Plug @ 270' w/40 sacks
- Set 3rd Plug @ 40' w/10 sacks
- 5 sacks Rathole
- 5 sacks Mousehole

RECEIVED
STATE CORPORATION COMMISSION

JAN 28 1982

CONSERVATION DIVISION
Wichita, Kansas

(If additional description is necessary, use BACK of this sheet)

Name of Plugging Contractor Halliburton Services
P.O. Box 579, Great Bend, KS 67530

1-28-82

STATE OF KANSAS COUNTY OF SEDGWICK, ss.
C.K. Morrison (employee of owner) or (~~owner or operator~~) of the
above-described well, being first duly sworn on oath, says: That I have knowledge of the
facts, statements, and matters herein contained and the log of the above-described well as
filed and that the same are true and correct. So help me God.

(Signature) [Signature]
555 N. Woodlawn Bldg. 1 - Suite 207
Wichita, (Address) KS 67208

SUBSCRIBED AND SWORN TO before me this 31 day of December, 19 81

Suzanne P. Graef
Notary Public.

My Commission expires: 10/26/85

