

15-147-00684-00-00

STATE OF KANSAS  
STATE CORPORATION COMMISSION

WELL PLUGGING RECORD

OR

FORMATION PLUGGING RECORD

Strike out upper line when reporting plugging off formations.

Give All Information Completely  
Make Required Affidavit  
Mail or Deliver Report to:  
Conservation Division  
State Corporation Commission  
800 Biting Building  
Wichita, Kansas

Phillips County, Sec. 9 Twp. 58 Rge. 17 (W)

Location as "NE $\frac{1}{4}$ NW $\frac{1}{4}$ SW $\frac{1}{4}$ " or footage from lines SW SW SE

Lease Owner Harbar Drlg. Co. - Jayhawk Oil Co.

Lease Name Wheaton Well No. 1

Office Address 201 W-K-H Bldg.

Character of Well (completed as Oil, Gas or Dry Hole) Dry Hole

Date well completed September 11 1943

Application for plugging filed August 9 1943

Application for plugging approved August 10 1943

Plugging commenced 19  


Plugging completed 19  

Reason for abandonment of well or producing formation Dry Hole

If a producing well is abandoned, date of last production 19  

Was permission obtained from the Conservation Division or its agents before plugging was commenced? Yes

NORTH

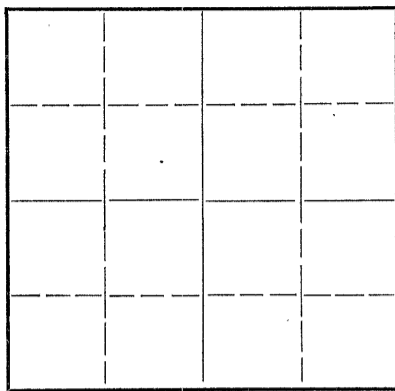

Locate well correctly on above Section Plat

Name of Conservation Agent who supervised plugging of this well Arbuckle

Producing formation Arbuckle Depth to top 3562 Bottom 3610 Total Depth of Well 3610 Feet

Show depth and thickness of all water, oil and gas formations.

OIL, GAS OR WATER RECORDS

CASING RECORD

Formation	Content	From	To	Size	Put In	Pulled Out
<u>Anhydrite</u>		<u>1380</u>		<u>10<math>\frac{3}{8}</math></u>	<u>192</u>	<u>None</u>
<u>Fort Riley</u>		<u>1960</u>		<u>5<math>\frac{1}{2}</math></u>	<u>3325</u>	
<u>Neva</u>		<u>2350</u>				
<u>Topeka</u>		<u>2875</u>				
<u>Lansing</u>	<u>Show of Oil</u>	<u>3095</u>				
<u>Conglomerate</u>		<u>3497</u>	<u>3515</u>			
<u>Simpson</u>		<u>3515</u>	<u>3562</u>			
<u>Arbuckle</u>		<u>3562</u>	<u>3610</u>			

Describe in detail the manner in which the well was plugged, indicating where the mud fluid was placed and the method or methods used in introducing it into the hold. If cement or other plugs were used, state the character of same and depth placed, from    feet to    feet for each plug set.

Cement Plug Back depth 3285. Mud 3285 to 3231; cement 3231 to 3197; mud 3197 to 250; cement 250 to 230; mud 230 to 20; cement 20 to 5; mud to surface.

(If additional description is necessary, use BACK of this sheet)

Correspondence regarding this well should be addressed to The Jayhawk Oil Co. Address Wichita, Kansas

STATE OF Kansas, COUNTY OF Sedgwick, ss. John M. Little (employee of owner) or (owner or operator) of the above-described well, being first duly sworn on oath, says: That I have knowledge of the facts, statements, and matters herein contained and the log of the above-described well as filed and that the same are true and correct. So help me God.

(Signature) John M. Little

201 W-K-H Bldg., Wichita, Kansas (Address)

SUBSCRIBED AND SWORN to before me this 20th day of October, 1943

My commission expires Oct. 24, 1944

Notary Public.

