

15-147-00030-00-00

STATE OF KANSAS
STATE CORPORATION COMMISSION

WELL PLUGGING RECORD

OR


FORMATION PLUGGING RECORD

Strike out upper line
when reporting plug-
ging off formations.

Give All Information Completely
Make Required Affidavit
Mail or Deliver Report to:
Conservation Division
State Corporation Commission
800 Biting Building
Wichita, Kansas

Phillips County. Sec. 22 Twp. 5 S. Rge. (E) 17 (W)
Location as "NE $\frac{1}{4}$ NW $\frac{1}{4}$ SW $\frac{1}{4}$ " or footage from lines. C NW $\frac{1}{4}$ SE $\frac{1}{4}$ SE $\frac{1}{4}$
Lease Owner. The Superior Oil Company
Lease Name. Steel Well No. 77-22
Office Address. Box #690; Chickasha, Oklahoma
Character of Well (completed as Oil, Gas or Dry Hole). Dry Hole
Date well completed. August 4 19 50
Application for plugging filed. 19 50
Application for plugging approved. August 3 19 50
Plugging commenced. August 4 19 50
Plugging completed. ditto 19
Reason for abandonment of well or producing formation. Dry
If a producing well is abandoned, date of last production. 19
Was permission obtained from the Conservation Division or its agents before plugging was com-
menced? Yes

NORTH

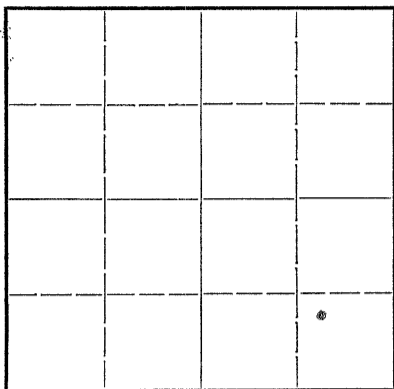

Locate well correctly on above
Section Plat

Name of Conservation Agent who supervised plugging of this well.
Producing formation. none Depth to top. Bottom. Total Depth of Well. 3523 Feet
Show depth and thickness of all water, oil and gas formations.

OIL, GAS OR WATER RECORDS

CASING RECORD

Formation	Content	From	To	Size	Put In	Pulled Out
				10"	228'	none
				8-5/8"	1298'	none

Describe in detail the manner in which the well was plugged, indicating where the mud fluid was placed and the method or methods used in introducing it into the hole. If cement or other plugs were used, state the character of same and depth placed, from feet to feet for each plug set.

Filled hole with heavy mud to 550'. Set 50' cement plug from 550-500. Cemented solid from 200' to surface w/65 sax cement.

RECEIVED

Conservation Div.

AUG 9 - 1950

ST

(If additional description is necessary, use BACK of this sheet)

Correspondence regarding this well should be addressed to The Superior Oil Company
Address. Box #690; Chickasha, Oklahoma

8-9-50

KANSAS

STATE OF Oklahoma, COUNTY OF Oklahoma, ss.
Floyd L. Martin, Jr. (employee of owner) or (owner or operator) of the above-described well,
being first duly sworn on oath, says: That I have knowledge of the facts, statements, and matters herein contained and the log of the above-described well as filed and that the same are true and correct. So help me God.

(Signature) Floyd L. Martin, Jr.

Box #690; Chickasha, Oklahoma
(Address)

SUBSCRIBED AND SWORN TO before me this 8th day of August, 19 50.

L. R. Stephens
L. R. STEPHENS Notary Public.

My commission expires July 15, 1950

21-871-s 9-45-6M

PLUGGING
FILE SEC 22 T 5 R 17 W
BOOK PAGE 20 LINE 10