


STATE OF KANSAS
STATE CORPORATION COMMISSION

Give All Information Completely
Make Required Affidavit
Mail or Deliver Report to:
Conservation Division
State Corporation Commission
800 Bittling Building
Wichita, Kansas

15-089-01012-00-00
WELL PLUGGING RECORD

Jewell County. Sec. 10 Twp. 5S Rge. 10W (E) (W)

Location as "NE/CNW $\frac{1}{4}$ SW $\frac{1}{4}$ " or footage from lines NE SW SW
Lease Owner Harry Mann
Lease Name Beard Well No. 1
Office Address 1017 Campbell, Beloit, Kansas
Character of Well (completed as Oil, Gas or Dry Hole) Dry Hole
Date well completed November 23, 1953 19
Application for plugging filed November 23, 1953 (verbal) 19
Application for plugging approved November 23, 1953 (verbal) 19
Plugging commenced November 23, 1953 19
Plugging completed November 23, 1953 19
Reason for abandonment of well or producing formation dry hole

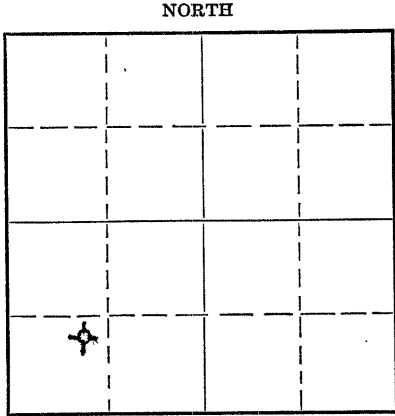

Locate well correctly on above Section Flat

If a producing well is abandoned, date of last production 19
Was permission obtained from the Conservation Division or its agents before plugging was commenced? Yes

Name of Conservation Agent who supervised plugging of this well Eldon Petty, Hays, Kansas
Producing formation Depth to top Bottom Total Depth of Well 4052 Feet
Show depth and thickness of all water, oil and gas formations.

OIL, GAS OR WATER RECORDS

CASING RECORD

Formation	Content	From	To	Size	Put In	Pulled Out
				8-5/8"	200'	

Describe in detail the manner in which the well was plugged, indicating where the mud fluid was placed and the method or methods used in introducing it into the hole. If cement or other plugs were used, state the character of same and depth placed, from feet to feet for each plug set.

Hole loaded with heavy rotary mud. Set bridge at 190 feet and dumped 15 sacks of cement on above bridge. Filled with heavy mud to near top and dumped 10 sacks of cement at top of surface pipe.

(If additional description is necessary, use BACK of this sheet)

Name of Plugging Contractor J. A. Melland
Address 1111 North Main, Hutchinson, Kansas

STATE OF KANSAS, COUNTY OF SEDGWICK, ss.

(employee of owner) or (owner or operator) of the above-described well, being first duly sworn on oath, says: That I have knowledge of the facts, statements, and matters herein contained and the log of the above-described well as filed and that the same are true and correct. So help me God.

(Signature) J. A. Melland

1111 North Main, Hutchinson, Kansas
(Address)

SUBSCRIBED AND SWORN to before me this 13th day of March, 1953.

RECEIVED
STATE CORPORATION COMMISSION

Notary Public.

My commission expires January 31, 1957

MAR 13 1953
23-8390-s 6-51-20M3
CONSERVATION DIVISION
Wichita, Kansas

PLUGGING
FILE SEC 10 T 5 R 1024
BOOK PAGE 62 LINE 16

3-13-53


19-089-01012-00-00

STATE OF KANSAS
STATE CORPORATION COMMISSION

WELL PLUGGING RECORD

Give All Information Completely
Make Required Affidavit
Mail or Deliver Report to:
Conservation Division
State Corporation Commission
800 Bittling Building
Wichita, Kansas

Jewell County. Sec. 10 Twp. 5S Rge. (E) 10 (W)
Location as "NE/CNW¹/₄SW¹/₄" or footage from lines Cen. S¹/₂ SW¹/₄ NE SWSW

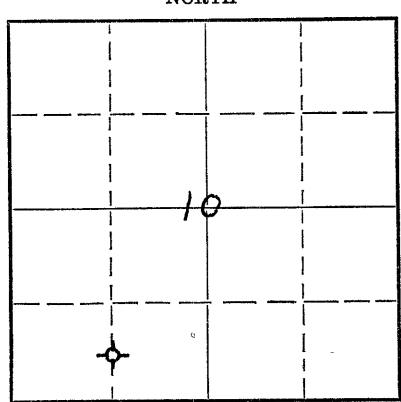

Locate well correctly on above
Section Flat

Lease Owner Harry Mann, et al
Lease Name Beard Well No. 1
Office Address 1017 North Campbell, Beloit, Kansas
Character of Well (completed as Oil, Gas or Dry Hole) Dry Hole
Date well completed November 23, 19 52
Application for plugging filed February 27, 19 53
Application for plugging approved November 23, 19 52
Plugging commenced November 27, 19 52
Plugging completed November 27, 19 52
Reason for abandonment of well or producing formation Dry Hole

If a producing well is abandoned, date of last production 19
Was permission obtained from the Conservation Division or its agents before plugging was commenced? Yes, verbally

Name of Conservation Agent who supervised plugging of this well Eldon Petty
Producing formation Depth to top Bottom Total Depth of Well Feet
Show depth and thickness of all water, oil and gas formations.

OIL, GAS OR WATER RECORDS

CASING RECORD

Formation	Content	From	To	Size	Put In	Pulled Out
				8-5/8"	190'	-

Describe in detail the manner in which the well was plugged, indicating where the mud fluid was placed and the method or methods used in introducing it into the hole. If cement or other plugs were used, state the character of same and depth placed, from feet to feet for each plug set.

From 4052' to 190' - Heavy mud.
Wood plug set at 190'
190' to 160' - 15 sacks cement.
160' to 40' - Heavy mud.
Wood plug set at 40'.
40' to 6' - 10 sacks cement.
6' to 0' - Surface soil.

(If additional description is necessary, use BACK of this sheet)
Name of Plugging Contractor J. A. Mellend, Drilling Contractor
Address 1111 North Main Street, Hutchinson, Kansas

STATE OF _____, COUNTY OF _____, SS.
(employee of owner) or (owner or operator) of the above-described well,
being first duly sworn on oath, says: That I have knowledge of the facts, statements, and matters herein contained and the log of the above-described well as filed and that the same are true and correct. So help me God

(Signature) Harry Mann
Beloit, Kans (Address)

SUBSCRIBED AND SWORN to before me this 17th day of March, 19 53
Notary Public.

My commission expires Jan 19-1955

23-8390-s 6-51-20M

RECEIVED
STATE CORPORATION COMMISSION
03-20-53
CONSERVATION DIVISION

15-089-01012-00-00

March 11, 1953

Mr. Jay Kyle, General Counsel
State Corporation Commission
New England Building
Topeka, Kansas

Dear Mr. Kyle:

Attached are copies of letters that I have written to Mr. Harry Mann and Mr. J. A. Melland with reference to a dry hole drilled and plugged by Mr. Melland for Mr. Mann.

The well is the Beard Well No. 1, located in the Center of SW SW of Section 10, Township 5 South, Range 10 West, Jewell County, Kansas. This well was plugged November 23, 1952, and plugging permission and instructions were given by our District Plugging Agent, Mr. Eldon Petty, Hays, Kansas. I am also enclosing a copy of a letter written to Mr. Mann by Mr. Melland.

In addition to the letters written, it was necessary that this Department go to the effort and expense of calling Mr. Melland on February 6, 1953, and again on February 17, 1953. I also called Mr. Harry Mann on February 26, 1953.

Since this Department has not been successful in its efforts to get the parties responsible for the drilling and plugging of this dry hole to comply with the plugging laws, I ask that the efforts of the Legal Department be directed to convict these offenders of our plugging laws.

Very truly yours,

STATE CORPORATION COMMISSION
CONSERVATION DIVISION

By _____
S. S. Greider

SSG:ms

cc: Mr. J. A. Melland
Mr. Harry Mann

*papers filed
& fee paid
by J. A. Melland
3-13-53
S.S.S.*

15-089-01012-00-0

February 26, 1953

Mr. J. A. Melland
1111 North Main
Hutchinson, Kansas

Dear Sir:

I called Mr. Harry Mann today and learned that he had moved to Beliot, Kansas. I asked why he had not signed and returned the plugging forms that you had furnished him and he stated that he had never received them. He also said that he has never received my letter dated February 4, 1953, with reference to the plugging of the Beard well No. 1, located in Jewell County, Kansas. He told me that he has a post office box at Cawker City, Kansas. Apparently his mail has not been forwarded on to him.

I told him that I would write and ask you to complete another set of plugging forms and mail them to him at 1017 North Campbell, Beliot, Kansas. If you will prepare another set of plugging forms and mail them to Mr. Mann and if we then do not receive these forms with the plugging fee of \$25.00 within a reasonable length of time, we will have no other choice but to refer this matter to our legal department.

Very truly yours,

STATE CORPORATION COMMISSION
CONSERVATION DIVISION

BY:

WELL PLUGGING SUPERVISOR

SSG:lmv

cc: Mr. Harry Mann
1017 North Campbell
Beliot, Kansas

15-089-01012-00-02

February 27, 1953

File: Beard Well No. 1

Mr. Harry Mann
1017 North Campbell
Beliot, Kansas

Dear Mr. Mann:

As per request of Mr. S. S. Greider, Well Plugging Supervisor for the State Corporation Commission, we are attaching herewith the necessary forms for you to sign to cover plugging of the Beard Well No. 1.

These forms are complete and require only your signature before a Notary Public with the exception of the Well Plugging Record. We have left the Oil, Gas or Water Record blank since we do not have the geological data available. This information should be filled in before mailing to the Commission.

We urge you to sign and mail these forms to the Commission at your earliest convenience attaching a draft in amount of \$25.00 to cover the plugging fee.

Yours very truly,

J. A. Melland
J. A. Melland

JAM:g
encl: 9
cc: Mr. S.S. Greider

RECEIVED
STATE CORPORATION COMMISSION
FEB 28 1953
CONSERVATION DIVISION
Wichita, Kansas

15-089-01012-00-00

1017 M. Campbell

February 4, 1953

Mr. Harry Mann
Cawker City, Kansas

Dear Sir:

Our records indicate that your Beard Well No. 1, located approximately NE SW SW of Section 10, Township 5 South, Range 10 West, Jewell County, Kansas, was plugged November 28, 1952. Since that date, we have mailed you a number of invoice notices requesting the payment of the plugging fee of \$25., as well as, the required plugging forms. The laws of the State of Kansas definitely state that plugging forms and fees shall be filed within a specified time after date of plugging. We ask that you comply with these plugging laws and furnish us with the above requested requirements without further delay.

Very truly yours,

STATE CORPORATION COMMISSION
CONSERVATION DIVISION

BY: S. S. GREIDER

SSG:lmv

cc: Mr. J. A. Melland

2-26-53
called Harry Mann
at Beard Well

3-4-53

Called
J. A. Melland
re: [unclear]

2-17-53
Mr. Melland says he furnished all of the papers to Mr. Mann to sign. Don't know why he won't sign & return them & pay fee. Will see him again this week.