

15023-20183-00-00


NOV 9 1981
11-9-81
CONSERVATION DIVISION
Wichita, Kansas

STATE OF KANSAS
STATE CORPORATION COMMISSION

WELL PLUGGING RECORD

Give All Information Completely
Make Required Affidavit
Mail or Deliver Report to
Conservation Division
State Corporation Comm.
245 North Water
Wichita, KS 67202

Cheyenne County, Sec. 24 Twp. 45 Rge. 42 E/W
Location as "NE/CNW 1/4 SW 1/4" or footage from lines
1320' FEL & 1320' FSL
Lease Owner Geochemical Surveys, Inc.
Lease Name R. Gunn Well No. 1
Office Address 2505 Turtle Creek Blvd.; Dallas, Texas 75219
Character of Well (Completed as Oil, Gas or Dry Hole) Dry Hole

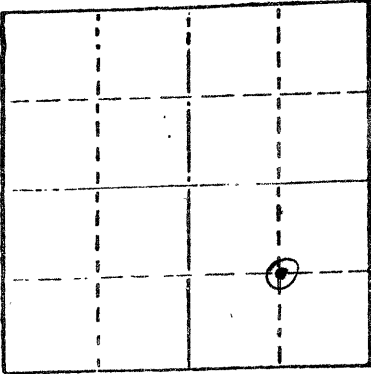

Locate well correctly on above
Section Plot

Date Well completed Sept. 22, 1981
Application for plugging filed Yes 1981
Application for plugging approved 10-29- 1981
Plugging commenced Sept. 23, 1981
Plugging completed Sept. 23, 1981
Reason for abandonment of well or producing formation Dry Hole

If a producing well is abandoned, date of last production 19

Was permission obtained from the Conservation Division or its agents before plugging was commenced? Yes

Name of Conservation Agent who supervised plugging of this well Mr. Carl Goodrow; Box 989; Penokee, KS
Producing formation Niobrara (top) Depth to top 1600' Bottom 2100' Total Depth of Well 1780'
Show depth and thickness of all water, oil and gas formations.

OIL, GAS OR WATER RECORDS

CASING RECORD

FORMATION	CONTENT	SETTING TO DEPTH	SIZE Hole	PUT IN	PHILLED OIL
SURFACE	Cement - 200 sks. (50/50 POZ)	300'	12"	24#	8 5/8"
No Producing Casing					
No Shows Oil/Gas					

Describe in detail the manner in which the well was plugged, indicating where the mud fluid was placed and the method or methods used in introducing it into the hold. If cement or other plugs were used, state the character of same and depth placed, from _____ feet to _____ feet for each plug set.

Extra caution taken to control the caving sand at shallow depths. Mud control exercised -- Aquagel, starch and salt were employed throughout drilling operation.

Too low structurally to be an economic producer.

(If additional description is necessary, use BACK of this sheet)

Name of Plugging Contractor _____

STATE OF TEXAS COUNTY OF DALLAS, ss.
William Duchscherer, Jr. - President (employee of owner) or (owner or operator)
of the above-described well, being first duly sworn on oath, says: That I have knowledge of the facts, statements, and matters herein contained and the log of the above-described well as filed and that the same are true and correct. So help me God.

(Signature)

2505 Turtle Creek Blvd.; Dallas, Texas 75219
(Address)

SUBSCRIBED AND SWORN TO before me this 5th day of November, 19 81

Betty Hoover
Notary Public.

My commission expires December 8, 1984