

15-023-00005-00-00

WELL PLUGGING RECORD

Give All Information Completely
Make Required Affidavit
Mail or Deliver Report to:
Conservation Division
State Corporation Commission
211 No. Broadway
Wichita, Kansas

Cheyenne County. Sec. 2 Twp. 4S Rge. 41 (#) (W)

Location as "NE/CNW/SW" or footage from lines. C NW/4 SW/4

Lease Owner R. G. Lawton

Lease Name W. E. Johnson Well No. 1

Office Address Box 620, Magnolia, Arkansas

Character of Well (completed as Oil, Gas or Dry Hole) Dry Hole

Date well completed September 11, 19 58

Application for plugging filed September 11, 19 58

Application for plugging approved September 11, 19 58


Plugging commenced 8:00 P. M. September 11, 19 58

Plugging completed 11:00 P. M. September 11, 19 58

Reason for abandonment of well or producing formation Dry Hole

If a producing well is abandoned, date of last production _____ 19 _____

Was permission obtained from the Conservation Division or its agents before plugging was commenced? Yes

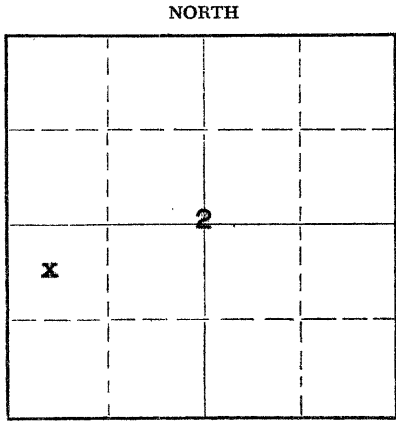

Locate well correctly on above Section Plat

Name of Conservation Agent who supervised plugging of this well A. D. Fadricius

Producing formation _____ Depth to top _____ Bottom _____ Total Depth of Well 5397 Feet

Show depth and thickness of all water, oil and gas formations.

OIL, GAS OR WATER RECORDS

CASING RECORD

FORMATION	CONTENT	FROM	TO	SIZE	PUT IN	PULLED OUT

Describe in detail the manner in which the well was plugged, indicating where the mud fluid was placed and the method or methods used in introducing it into the hole. If cement or other plugs were used, state the character of same and depth placed, from _____ feet to _____ feet for each plug set.

Cement plugs set by Halliburton:

(1) Plug set @ 600' with 25 sacks cement

(2) Plug set @ 220' with 15 sacks cement

(3) Plug set from 40' to surface with 10 sacks cement

RECEIVED
10-12-1958
OCT 2 1 50
DIVISION
WICHITA, KANSAS

(If additional description is necessary, use BACK of this sheet)

Name of Plugging Contractor Halliburton Oil Well Cementing Company

Address Hays, Kansas

STATE OF Arkansas, COUNTY OF Columbia, ss.

J. R. McLaughlin (employee of owner) or (owner or operator) of the above-described well, being first duly sworn on oath, says: That I have knowledge of the facts, statements, and matters herein contained and the log of the above-described well as filed and that the same are true and correct. So help me God.

(Signature) J. R. McLaughlin

P. O. Box 620, Magnolia, Arkansas

(Address)

SUBSCRIBED AND SWORN TO before me this 25th day of September, 19 58

My commission expires April 15, 1961

J. Fred Jordan
Notary Public.

PLUGGING
FILE SEC 2 T. 4 R. 41W
BOOK PAGE 129 LINE 15

15-023-00005-00-00

ROTARY DRILLERS LOG

COMPANY : R. G. Lawton
Magnolia, Arkansas

ROTARY DRILLING COMMENCED: 8-21-58

CONTRACTOR : R. G. Lawton
Magnolia, Arkansas

ROTARY DRILLING COMPLETED: 9-11-58

CASING RECORD: Set 10 3/4" @ 203' emt.
250 sax cement

LOCATION: Johnson #1
C NW SW 2-4S-41W
Cheyenne County, Kansas

ELEVATION : 3475 K.B.

PRODUCTION: Dry

(Figures indicate bottom of formation - measurements from top of Rotary Bushing)

1300	Grey Shale (Pierre)	3835	Lime
1815	Grey chalky Shale (Niebrara)	3885	Shale
1900	White chalky lime (Ft. Hays)	3920	Lime
2130	Grey shale	4160	Shale and lime
2225	Lime and shale	4190	Lime
2310	Black shale	4370	Lime and shale
2510	Sand (Dakota)	4410	Lime
2640	Shale with lime streaks	4432	Broken lime and shale
2810	Sand	4635	Lime with shale streaks (Lansing)
3020	Shale with lime streaks (Morrison)	4765	Shale with lime streaks
3285	Red shale and anhydrite	5045	Broken lime
3315	Anhydrite (Cimarron)	5132	Shale
3465	Broken sand and shale	5139	Sand
3485	Lime	5143	Shale
3732	Red shale with lime streaks	5343	Lime and chert (Miss.)
3748	Lime	5397	Dolomite (Arbuckle)
3815	Red shale		

Driller's total depth 5377'. All formations tops corrected to Schlumberger total depth 5397'.

Jim McLaughlin
Jim McLaughlin

STATE OF ARKANSAS)
COUNTY OF COLUMBIA) SS

Subscribed and sworn to before me this 25th day of September, 1958.

My commission expires:
April 15, 1961

John Jackson
Notary Public

RECEIVED
OCT 2 1958
SEARCH DIVISION
WICHITA, KANSAS

PLUGGING
FILE SEC 2 T 4 R 41W
BOOK PAGE 129 LINE 15