

For KCC Use: 11-21-04  
Effective Date: 2  
District # \_\_\_\_\_  
SGA?  Yes  No

KANSAS CORPORATION COMMISSION  
OIL & GAS CONSERVATION DIVISION  
**NOTICE OF INTENT TO DRILL**

OWWO

Form C-1  
December 2002  
**Form must be Typed**  
**Form must be Signed**  
**All blanks must be Filled**

Must be approved by KCC five (5) days prior to commencing well

Expected Spud Date December 1 2004  
month day year

OPERATOR: License# 5030  
Name: Vess Oil Corporation  
Address: 8100 E. 22nd St North, Bldg. 300  
City/State/Zip: Wichita, KS 67226  
Contact Person: W.R. Horigan  
Phone: 316-682-1537 X102

CONTRACTOR: License# 32991  
Name: Simmons Well Service, Inc.

| Well Drilled For:                                  | Well Class:                                    | Type Equipment:                               |
|--|--|---|
| <input checked="" type="checkbox"/> Oil            | <input type="checkbox"/> Enh Rec               | <input type="checkbox"/> Infield              |
| <input type="checkbox"/> Gas                       | <input type="checkbox"/> Storage               | <input checked="" type="checkbox"/> Pool Ext. |
| <input checked="" type="checkbox"/> OWWO           | <input type="checkbox"/> Disposal              | <input type="checkbox"/> Wildcat              |
| <input type="checkbox"/> Seismic; _____ # of Holes | <input type="checkbox"/> Other                 | <input checked="" type="checkbox"/> Cable     |
| <input checked="" type="checkbox"/> Other          | <u>Pulling unit, mud pump and power swivel</u> |   |

If OWWO: old well information as follows:   
Operator: Cities Service Oil Company  
Well Name: Wilson A #300  
Original Completion Date: 8/5/59 Original Total Depth: 2155'

Directional, Deviated or Horizontal wellbore?  Yes  No  
If Yes, true vertical depth: \_\_\_\_\_  
Bottom Hole Location: \_\_\_\_\_  
KCC DKT #: \_\_\_\_\_

Spot 95'E and 90'S  East  
NW - SW - SE Sec. 8 Twp. 25 S. R. 05  West  
900' feet from  N /  S Line of Section  
2215' feet from  E /  W Line of Section

Is SECTION  Regular  Irregular?  
(Note: Locate well on the Section Plat on reverse side)

County: Butler  
Lease Name: Wilson A Well #: 300 OWWO  
Field Name: El Dorado

Is this a Prorated / Spaced Field?  Yes  No  
Target Information(s): White Cloud  
Nearest Lease or unit boundary: 900'  
Ground Surface Elevation: 1367 feet MSL

Water well within one-quarter mile:  Yes  No  
Public water supply well within one mile:  Yes  No

Depth to bottom of fresh water: 160  
Depth to bottom of usable water: 180  
Surface Pipe by Alternate:  1  2

Length of Surface Pipe Planned to be set: 749' ok.  
Length of Conductor Pipe required: none  
Projected Total Depth: 1050'

Formation at Total Depth: White Cloud  
Water Source for Drilling Operations:  
 Well  Farm Pond Other  X

DWR Permit #: \_\_\_\_\_  
(Note: Apply for Permit with DWR )  
Will Cores be taken?  Yes  No  
If Yes, proposed zone: \_\_\_\_\_

**AFFIDAVIT**

The undersigned hereby affirms that the drilling, completion and eventual plugging of this well will comply with K.S.A. 55 et. seq.

It is agreed that the following minimum requirements will be met:

1. Notify the appropriate district office **prior** to spudding of well;
2. A copy of the approved notice of intent to drill **shall be** posted on each drilling rig;
3. The minimum amount of surface pipe as specified below **shall be set** by circulating cement to the top; in all cases surface pipe **shall be set** through all unconsolidated materials plus a minimum of 20 feet into the underlying formation.
4. If the well is dry hole, an agreement between the operator and the district office on plug length and placement is necessary **prior to plugging**;
5. The appropriate district office will be notified before well is either plugged or production casing is cemented in;
6. If an ALTERNATE II COMPLETION, production pipe shall be cemented from below any usable water to surface within **120 days** of spud date.  
Or pursuant to Appendix "B" - Eastern Kansas surface casing order #133,891-C, which applies to the KCC District 3 area, alternate II cementing must be completed within 30 days of the spud date or the well shall be plugged. **In all cases, NOTIFY district office** prior to any cementing.

I hereby certify that the statements made herein are true and to the best of my knowledge and belief.

Date: 11/12/04 Signature of Operator or Agent: Charles Casey Coats Title: Operations Engineer

**For KCC Use ONLY**  
API # 15 - 015-19514-00-01  
Conductor pipe required NONE feet  
Minimum surface pipe required 749' set feet per Alt. 1  
Approved by: RJP 11-16-04  
This authorization expires: 5-16-05  
(This authorization void if drilling not started within 6 months of effective date.)  
Spud date: \_\_\_\_\_ Agent: \_\_\_\_\_

**Remember to:**

- File Drill Pit Application (form CDP-1) with Intent to Drill;
- File Completion Form ACO-1 within 120 days of spud date;
- File acreage attribution plat according to field proration orders;
- Notify appropriate district office 48 hours prior to workover or re-entry;
- Submit plugging report (CP-4) after plugging is completed;
- Obtain written approval before disposing or injecting salt water.
- If this permit has expired (See: authorized expiration date) please check the box below and return to the address below.

**Well Not Drilled - Permit Expired**  
Signature of Operator or Agent: \_\_\_\_\_  
Date: \_\_\_\_\_

Mail to: KCC - Conservation Division, 130 S. Market - Room 2078, Wichita, Kansas 67202

0  
25  
52

**IN ALL CASES PLOT THE INTENDED WELL ON THE PLAT BELOW**

*Plat of acreage attributable to a well in a prorated or spaced field*

**If the intended well is in a prorated or spaced field, please fully complete this side of the form.** If the intended well is in a prorated or spaced field complete the plat below showing that the well will be properly located in relationship to other wells producing from the common source of supply. Please show all the wells and within 1 mile of the boundaries of the proposed acreage attribution unit for gas wells and within 1/2 mile of the boundaries of the proposed acreage attribution unit for oil wells.

API No. 15 - \_\_\_\_\_  
 Operator: Vess Oil Corporation  
 Lease: Wilson A  
 Well Number: 300 OWWO  
 Field: El Dorado  
 Number of Acres attributable to well: \_\_\_\_\_  
 QTR / QTR / QTR of acreage: NW - SW - SE

Location of Well: County: Butler  
900' feet from  N /  S Line of Section  
2215' feet from  E /  W Line of Section  
 Sec. 8 Twp. 25 S. R. 05  East  West


Is Section:  Regular or  Irregular

**If Section is Irregular, locate well from nearest corner boundary.**


Section corner used:  NE  NW  SE  SW

**PLAT**

*(Show location of the well and shade attributable acreage for prorated or spaced wells.)  
 (Show footage to the nearest lease or unit boundary line.)*

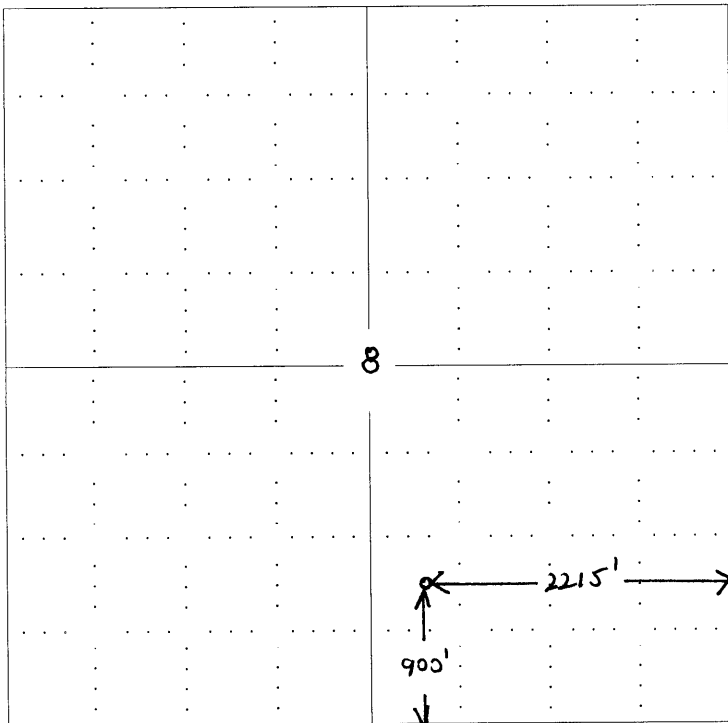

RECEIVED  
 NOV 15 2004  
 KCC WICHITA

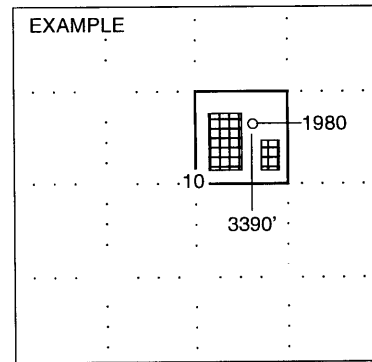

**NOTE: In all cases locate the spot of the proposed drilling location.**

**In plotting the proposed location of the well, you must show:**

1. The manner in which you are using the depicted plat by identifying section lines, i.e. 1 section, 1 section with 8 surrounding sections, 4 sections, etc.
2. The distance of the proposed drilling location from the section's south / north and east / west.
3. The distance to the nearest lease or unit boundary line.
4. If proposed location is located within a prorated or spaced field a certificate of acreage attribution plat must be attached: (C0-7 for oil wells; CG-8 for gas wells).