15-147-00691-00-00

STATE OF KANSAS
STATE CORPORATION COMMISSION

Give All Information Completely
Make Required Affidavit
Mail or Deliver Report to:
Conservation Division
State Corporation Commission
800 Bitting Building
Wichita, Kansas

WELL PLUGGING RECORD

NORTH

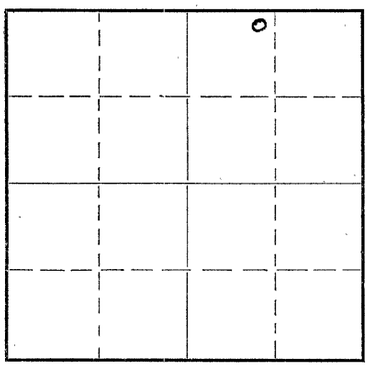

Locate well correctly on above Section Plat

Phillips County. Sec. 25 Twp. 5 Rge. 18 (E) (W)

Location as "NE/CNW¼SW¼" or footage from lines NE NW NE

Lease Owner A. H. Kasishke (Alkay Oil Co.)

Lease Name J. R. Donaldson Well No. 2

Office Address 929 Kennedy Building, Tulsa, Oklahoma

Character of Well (completed as Oil, Gas or Dry Hole) Dry Hole

Date well completed June 11, 19 51

Application for plugging filed June 11, 19 51

Application for plugging approved June 11, 19 51

Plugging commenced June 11, 19 51

Plugging completed June 11, 19 51

Reason for abandonment of well or producing formation Dray Hole

If a producing well is abandoned, date of last production 19

Was permission obtained from the Conservation Division or its agents before plugging was commenced? Yes

Name of Conservation Agent who supervised plugging of this well Eldon Patty, Box 326, Hays, Kansas.

Producing formation Depth to top Bottom Total Depth of Well Feet

Show depth and thickness of all water, oil and gas formations.

OIL, GAS OR WATER RECORDS — CASING RECORD

Formation	Content	From	To	Size	Put In	Pulled Out
		O	155'	8 5/8"	Yes	No
	8 5/8" Surface Casing cemented @ 155' w/100 sacks cement cement circulated.					

Describe in detail the manner in which the well was plugged, indicating where the mud fluid was placed and the method or methods used in introducing it into the hole. If cement or other plugs were used, state the character of same and depth placed, from feet to feet for each plug set.

Heavy Mud spotted @ 3281' back to 140'
Plug set @ 140' with 1/2 Sack cotten seed hulls
Cemented with 15 sacks cement 140' to 40'
Plug set @ 40' with 1/2 Sack cotton seed hulls
Cemented with 10 sacks cement @ 40' to 0'

6-28-51

STATE CORPORATION COMMISSION
JUN 28 1951
CONSERVATION DIVISION
Wichita, Kansas

(If additional description is necessary, use BACK of this sheet)

Correspondence regarding this well should be addressed to Alkay Oil Company

Address 929 Kennedy Building, Tulsa, Oklahoma

STATE OF OKLAHOMA, COUNTY OF TULSA, ss.

E. G. Moehlenkamp (employee of owner) or (~~owner or operator~~) of the above-described well, being first duly sworn on oath, says: That I have knowledge of the facts, statements, and matters herein contained and the log of the above-described well as filed and that the same are true and correct. So help me God.

(Signature) E G Moehlenkamp

929 Kennedy Bldg - Tulsa Okla
(Address)

SUBSCRIBED AND SWORN TO before me this 27th day of June, 19 51

Margaret Bivins
Notary Public.

My commission expires March 8, 1954

22-5133-s 9-48—10M

PLUGGING
FILE SEC. 25 T. 5 R. 18
BOOK PAGE 88 LINE 23