


WELL PLUGGING RECORD

Give All Information Completely  
Make Required Affidavit  
Mail or Deliver Report to:  
Conservation Division  
State Corporation Commission  
211 No. Broadway  
Wichita, Kansas

Phillips County, Sec. 16 Twp. 5S Rge. 18W (E) (W)

Location as "NE/CNW%SW%" or footage from lines SW SW SW  
Lease Owner Petroleum Management, Inc.  
Lease Name Bretton Well No. 1  
Office Address 1515 Wichita Plaza, Wichita, Kansas  
Character of Well (completed as Oil, Gas or Dry Hole) Dry Hole  
Date well completed June 21, 19 65  
Application for plugging filed June 21, 19 65  
Application for plugging approved June 21, 19 65  
Plugging commenced June 21, 19 65  
Plugging completed June 21, 19 65  
Reason for abandonment of well or producing formation D & A

NORTH

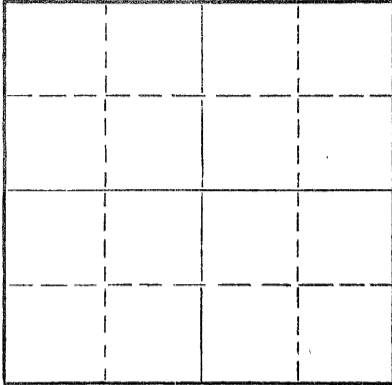

Locate well correctly on above  
Section Plat

If a producing well is abandoned, date of last production 19  
Was permission obtained from the Conservation Division or its agents before plugging was commenced? Yes

Name of Conservation Agent who supervised plugging of this well Eldon Petty  
Producing formation \_\_\_\_\_ Depth to top \_\_\_\_\_ Bottom \_\_\_\_\_ Total Depth of Well 3725 Feet  
Show depth and thickness of all water, oil and gas formations.

OIL, GAS OR WATER RECORDS

CASING RECORD

| FORMATION | CONTENT | FROM | TO | SIZE   | PUT IN | PULLED OUT |
|-----------|---------|------|----|--------|--------|------------|
|           |         |      |    | 8 5/8" | 196*   | -0-        |
|           |         |      |    |        |        |            |
|           |         |      |    |        |        |            |
Describe in detail the manner in which the well was plugged, indicating where the mud fluid was placed and the method or methods used in introducing it into the hole. If cement or other plugs were used, state the character of same and depth placed, from \_\_\_\_\_ feet to \_\_\_\_\_ feet for each plug set.

Filled hole w/heavy mud to 540', plug & 20 sx cement.  
Filled hole w/heavy mud to 190', plug & 20 sx cement.  
Filled hole w/heavy mud to 35', plug, 1/2 sx hulls & 10 sx cement.

RECEIVED  
STATE CORPORATION COMMISSION

AUG 2 - 1965

CONSERVATION DIVISION  
Wichita, Kansas

Name of Plugging Contractor Red Tiger Drilling Company  
Address Box 173 -- Russell, Kansas

(If additional description is necessary, use BACK of this sheet)

8-2-65

STATE OF KANSAS, COUNTY OF SEDGWICK, ss.  
Maxine V. Head (employee of owner) or (owner or operator) of the above-described well, being first duly sworn on oath, says: That I have knowledge of the facts, statements, and matters herein contained and the log of the above-described well as filed and that the same are true and correct. So help me God.

(Signature) Maxine V. Head  
1720 Wichita Plaza, Wichita, Kansas (Address)

SUBSCRIBED AND SWORN TO before me this 29th day of June, 19 65

My commission expires 5-22-66 Notary Public.