


STATE OF KANSAS  
STATE CORPORATION COMMISSION

15-147-00070-00-00

WELL PLUGGING RECORD

Give All Information Completely  
Make Required Affidavit  
Mail or Deliver Report to:  
Conservation Division  
State Corporation Commission  
800 Bitting Building  
Wichita, Kansas

Phillips County. Sec. 14 Twp. 5-S Rge. 18 ~~(E)~~ W (W)  
Location as "NE/CNW $\frac{1}{4}$ /SW $\frac{1}{4}$ " or footage from lines SE SE NW  
Lease Owner Laura Jane Oil Company and B - H - P  
Lease Name Maddox Well No. 1  
Office Address Box 62, Great Bend, Kansas  
Character of Well (completed as Oil, Gas or Dry Hole) Dry Hole  
Date well completed February 6, 1951  
Application for plugging filed February 9, 1951  
Application for plugging approved 19  
Plugging commenced February 6, 1951  
Plugging completed February 6, 1951  
Reason for abandonment of well or producing formation Dry Hole  
If a producing well is abandoned, date of last production - - - - - 19 -  
Was permission obtained from the Conservation Division or its agents before plugging was commenced? Yes

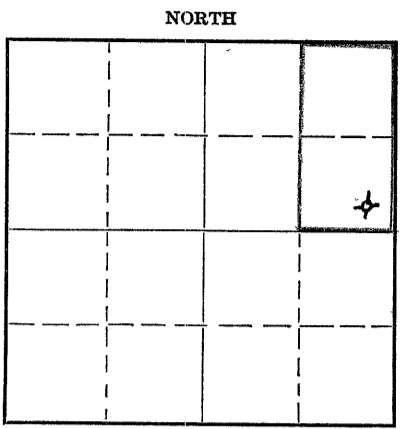

Locate well correctly on above Section Plat

Name of Conservation Agent who supervised plugging of this well  
Producing formation - - - - - Depth to top - - - - - Bottom - - - - - Total Depth of Well 3600 Feet  
Show depth and thickness of all water, oil and gas formations.

OIL, GAS OR WATER RECORDS

CASING RECORD

Formation	Content	From	To	Size	Put In	Pulled Out
				8-5/8"	160'	x x x x

Describe in detail the manner in which the well was plugged, indicating where the mud fluid was placed and the method or methods used in introducing it into the hole. If cement or other plugs were used, state the character of same and depth placed, from 3600 feet to 0 feet for each plug set.

Filled hole with heavy mud to bottom of surface pipe; ran bottom plug to 150'; cemented with 15 sacks of cement; ran top plug to 40'; cemented with 10 sacks of cement.

RECEIVED  
STATE CORPORATION COMMISSION  
FEB 21 1951  
CONSERVATION DIVISION  
Wichita, Kansas

2-21-51

(If additional description is necessary, use BACK of this sheet)  
Correspondence regarding this well should be addressed to B - H - P  
Address Box 62, Great Bend, Kansas

STATE OF Barton COUNTY OF Kansas, ss.  
Leon F. Huff, Partner of B - H - P (Employer of owner) or (owner or operator) of the above-described well,

being first duly sworn on oath, says: That I have knowledge of the facts, statements, and matters herein contained and the log of the above-described well as filed and that the same are true and correct. So help me God.

(Signature) *Leon F. Huff*  
Box 62, Great Bend, Kansas  
(Address)

SUBSCRIBED AND SWORN to before me this 13th day of February, 1951

My commission expires March 6, 1954  
Notary Public.

PLUGGING  
FILE SEC 147 S R164  
BOOK PAGE 61 LINE 15