


Give All Information Completely
Make Required Affidavit
Mail or Deliver Report to:
Conservation Division
State Corporation Commission
212 North Market, Insurance Bldg.
Wichita, Kansas

WELL PLUGGING RECORD

NORTH

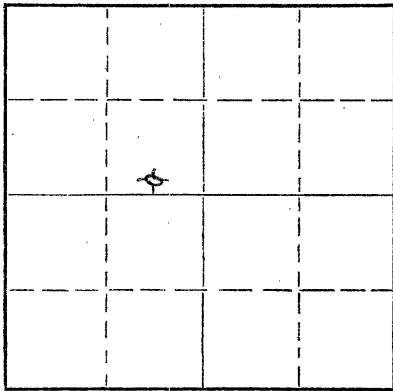

Locate well correctly on above
Section Plat

Phillips County. Sec. 14 Twp. 5S Rge. 18 (E) W (W)
Location as "NE/CNW4SW4" or footage from lines CSL SE NW
Lease Owner Birmingham-Bartlett Drilling Co.
Lease Name MADDOX "A" Well No. 1
Office Address 300 Kaufman Bldg., Wichita 2, Kansas
Character of Well (completed as Oil, Gas or Dry Hole) Dry Hole
Date well completed May 12, 19 62
Application for plugging filed (verbal) May 12, 19 62
Application for plugging approved (verbal) May 12, 19 62
Plugging commenced May 12, 19 62
Plugging completed May 12, 19 62
Reason for abandonment of well or producing formation Dry Hole

If a producing well is abandoned, date of last production 19
Was permission obtained from the Conservation Division or its agents before plugging was commenced? Yes

Name of Conservation Agent who supervised plugging of this well Eldon Petty
Producing formation _____ Depth to top _____ Bottom _____ Total Depth of Well 3711 Feet
Show depth and thickness of all water, oil and gas formations.

OIL, GAS OR WATER RECORDS

CASING RECORD

FORMATION	CONTENT	FROM	TO	SIZE	PUT IN	PULLED OUT
		0	213'	8-5/8"	213'	none

Describe in detail the manner in which the well was plugged, indicating where the mud fluid was placed and the method or methods used in introducing it into the hole. If cement or other plugs were used, state the character of same and depth placed, from _____ feet to _____ feet for each plug set.

Set plug at 550' - mix 20 sacks cement, spot through drill pipe.
2nd plug at 180' - mix 20 sacks cement, spot through drill pipe.
3rd plug at 35' - mix and dump 10 sacks cement filling to base of cellar.

RECEIVED
STATE CORPORATION COMMISSION
MAY 17 1962
CONSERVATION DIVISION
Wichita, Kansas
5-17-62

(If additional description is necessary, use BACK of this sheet)
Name of Plugging Contractor Birmingham-Bartlett Drilling Co.
Address 300 Kaufman Bldg., Wichita 2, Kansas

STATE OF Kansas, COUNTY OF Sedgwick, ss. contractor,
Richard Hindery, Partner of Birmingham-Bartlett Drilling Co., owner & operator
well, being first duly sworn on oath, says: That I have knowledge of the facts, statements, and matters herein contained and the log of the above-described well as filed and that the same are true and correct. So help me God. BIRMINGHAM-BARTLETT DRILLING CO.

(Signature) By Richard Hindery Partner
300 Kaufman Bldg., Wichita 2, Kansas
(Address)

SUBSCRIBED AND SWORN TO before me this 16th day of May, 19 62.

My commission expires October 2, 1962.
Beverly Larson
Beverly Larson Notary Public.

