


STATE OF KANSAS
STATE CORPORATION COMMISSION

WELL PLUGGING RECORD

Give All Information Completely
Make Required Affidavit
Mail or Deliver Report to
Conservation Division
State Corporation Comm.
245 North Water
Wichita, KS 67202

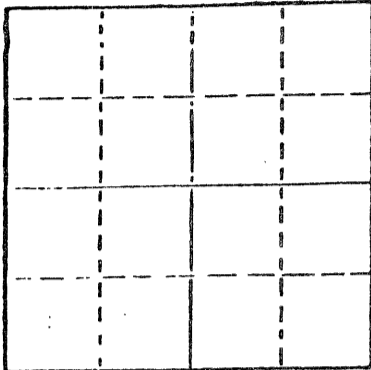

Locate well correctly on above
Section Plat

Phillips County, Sec. 10 Twp. 5S Rge. 18 E/W
Location as "NE/CNW $\frac{1}{4}$ SW $\frac{1}{4}$ " or footage from lines

SW NW NE

Lease Owner Rains & Williamson Oil Co., Inc.

Lease Name Shaw "A" Well No. #1

Office Address 435 Page Court, 220 W. Douglas, Wichita, KS.

Character of Well (Completed as Oil, Gas or Dry Hole) Dry Hole

Date Well completed 9-10-76 19

Application for plugging filed 9-10-76 19

Application for plugging approved 9-10-76 19

Plugging commenced 9-10-76 19

Plugging completed 9-10-76 19

Reason for abandonment of well or producing formation Commercial quantities of oil not found.

If a producing well is abandoned, date of last production 19

Was permission obtained from the Conservation Division or its agents before plugging was commenced? Yes

Name of Conservation Agent who supervised plugging of this well Leo Massey, Hays, Ks.

Producing formation Depth to top Bottom Total Depth of Well 3375'

Show depth and thickness of all water, oil and gas formations.

OIL, GAS OR WATER RECORDS

CASING RECORD

FORMATION	CONTENT	FROM	TO	SIZE	PUT IN	PULLED OUT
				8 5/8"	207'	none

Describe in detail the manner in which the well was plugged, indicating where the mud fluid was placed and the method or methods used in introducing it into the hold. If cement or other plugs were used, state the character of same and depth placed, from feet to feet for each plug set.

Plug @ 800' w/70 sx.

Plug @ 185' w/20 sx.

Plug @ 40' w/10 sx.

RECEIVED
STATE CORPORATION COMMISSION

SEP 17 1976

CONSERVATION DIVISION
Wichita, Kansas

9-17-76

(If additional description is necessary, use BACK of this sheet)

Name of Plugging Contractor Rains & Williamson Oil Co., Inc.

STATE OF Kansas COUNTY OF Sedgwick, ss.
Wilson Rains, President of Rains & Williamson Oil Co. Inc. (employee of owner) or (owner or operator)
of the above-described well, being first duly sworn on oath, says: That I have knowledge of the facts, statements, and matters herein contained and the log of the above-described well as filed and that the same are true and correct. So help me God.

(Signature)

Wilson Rains
435 Page Court, 220 W. Douglas, Wichita,
(Address)

SUBSCRIBED AND SWORN TO before me this 16 day of September, 1976

My commission expires 10-4-79

Juanita M. Green
Juanita M. Green Notary Public.

