

15-147-19106-00-00

STATE OF KANSAS
STATE CORPORATION COMMISSION

Give All Information Completely
Make Required Affidavit
Mail or Deliver Report to:
Conservation Division
State Corporation Commission
800 Bitting Building
Wichita, Kansas

WELL PLUGGING RECORD
OR
FORMATION PLUGGING RECORD

Strike out upper line
when reporting plug-
ging off formations.

pd.
8/20/40
Hess

PHillips County. Sec. 25. Twp. 5. Rge. (E) 18 (W) 17

Location as "NE $\frac{1}{4}$ NW $\frac{1}{4}$ SW $\frac{1}{4}$ " or footage from lines.

Lease Owner. Donaldson (C.R.E. Hess & Son)

Lease Name. Donaldson Well No. 2

Office Address. Stockton

Character of Well (Completed as Oil, Gas or Dry Hole). Dryhole

Date, well completed. August 5, 1940

Application for plugging filed. August 5, 1940

Application for plugging approved. August 6, 1940


Plugging Commenced. August 6, 1940

Plugging Completed. August 12, 1940

Reason for abandonment of well or producing formation. dry hole

If a producing well is abandoned, date of last production. 193

Was permission obtained from the Conservation Division or its agents before plugging was com-
menced? yes

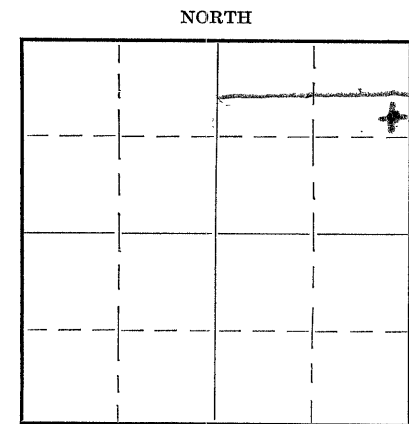

Locate well correctly on above
Section Plat

Name of Conservation Agent who supervised plugging of this well. Alexander, Great Bend, Kansas

Producing formation. Depth to top. Bottom. Total Depth of Well. 3165 Feet.

Show depth and thickness of all water, oil and gas formations.

OIL, GAS OR WATER RECORDS

CASING RECORD


Formation	Content	From	To	Size	Put In	Pulled Out
Light shale	5 b. w.		505'	20"	25'	25'
Sand	h. f. w.		585'	15 $\frac{1}{2}$ "	475'	475'
lime	1 b. w.		2215'	12 $\frac{3}{8}$ "	1041'	1041'
				10"	1344'	1280'
				8 $\frac{1}{2}$ "	2380'	2380'
				6 5-8"	3112'	3112'

Describe in detail the manner in which the well was plugged, indicating where the mud fluid was placed and the method or methods used in introducing it into the hole. If cement or other plugs were used, state the character of same and depth placed, from feet to feet for each plug set.

Hole filled with mud 3155' to bottom of cellar and capped at top with cement.

pd.
8/20/40
Hess

PLUGGING
FILE SEC 25-5-R-18
BOOK PAGE 112 LINE 32

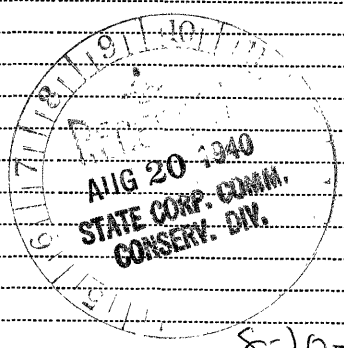

(If additional description is necessary, use BACK of this sheet)

Correspondence regarding this well should be addressed to R. E. Hess & Son
Address Stockton, Kansas

8-20-40

STATE OF Kansas COUNTY OF Phillips, ss.

Howard Hess (employee of owner) or (owner or operator) of the above-described well, being first duly sworn on oath, says: That I have knowledge of the facts, statements, and matters herein contained and the log of the above-described well as filed and that the same are true and correct. So help me God.

(Signature) Howard Hess

(Address)

SUBSCRIBED AND SWORN to before me this 16th day of August, 1940

My commission expires 10-24-47

W.C. Sullivan

Notary Public.

CASING RECORD

20"	25'
15 $\frac{1}{2}$ "	475'
12 $\frac{1}{2}$ "	1041'
10"	1344'
8 $\frac{1}{2}$ "	2380'
6 5-8"	3112'

WATER RECORD

5 b. w. at 505'
h. f. w. at 585'
1 b. w. at 2215'