

CARD MUST BE TYPED

State of Kansas

CARD MUST BE SIGNED

NOTICE OF INTENTION TO DRILL

(see rules on reverse side)

Starting Date ... 8-29-85 ... month day year

API Number 15- 147-20,486-00-00

OPERATOR: License # ... 5706
Name ... L. and F. Oil Operations
Address ... P.O. Box 415
City/State/Zip ... Plainville, KS 67663
Contact Person ... Floyd E. Kelly
Phone ... (913) 434-2830

... NE SE NE ... Sec. 10. Twp. 5 S, Rg. 18 ... East
... 3630 ... Ft. from South Line of Section
... 330 ... Ft. from East Line of Section

(Note: Locate well on Section Plat on reverse side)

CONTRACTOR: License # ... 8241
Name ... Emphasis Oil Operations
City/State ... P.O. Box 506, Russell, KS 67665-0506

Nearest lease or unit boundary line ... 660 ... feet
County ... Phillips

Lease Name ... Shaw ... Well # ... 2
Ground surface elevation ... N/A ... feet MSL

Well Drilled For: Well Class: Type Equipment:
[X] Oil [] SWD [X] Infield [X] Mud Rotary
[] Gas [] Inj [] Pool Ext. [] Air Rotary
[] OWWO [] Expl [] Wildcat [] Cable

Domestic well within 330 feet: [X] yes [] no
Municipal well within one mile: [X] yes [] no
Surface pipe by Alternate: 1 [] 2 [X]

If OWWO: old well info as follows:
Operator
Well Name
Comp Date ... Old Total Depth

Depth to bottom of fresh water ... 100
Depth to bottom of usable water ... 900
Surface pipe planned to be set ... 250
Projected Total Depth ... 3450
Formation ... Kansas City

I certify that well will comply with K.S.A. 55-101, et seq., plus eventually plugging hole to KCC specifications. Production string will be

... immediately cemented from below usable
Date ... 8-29-85 ... Signature of Operator or Agent ... Title Agent ... water to surface ...


For KCC Use:
Conductor Pipe Required ... feet; Minimum Surface Pipe Required ... feet per Alt. 1 2
This Authorization Expires ... 3-2-86 ... Approved By ... 8-30-85

Must be filed with the K.C.C. five (5) days prior to commencing well
 This card void if drilling not started within six (6) months of date received by K.C.C.

Important procedures to follow:

1. Notify District office before setting surface casing.
2. Set surface casing by circulating cement to the top.
3. File completion forms ACO-1 with K.C.C. within 90 days of well completion, following instructions on ACO-1, side 1, and including copies of wireline logs.
4. Notify District office 48 hours prior to old well workover or re-entry.
5. Prior to filing Intent, prepare a proposed plugging plan in case well is D & A, then obtain approval of plan when calling district office prior to setting surface pipe.
6. Submit plugging report (CP-4) to K.C.C. after plugging is completed.
7. Obtain an approved injection docket number before disposing of salt water.
8. Notify K.C.C. within 10 days when injection commences or terminates.
9. Run an alternate 2 completion, cement in the production pipe from below any usable water to surface within 120 days of spud date.

A Regular Section of Land
1 Mile = 5,280 Ft.

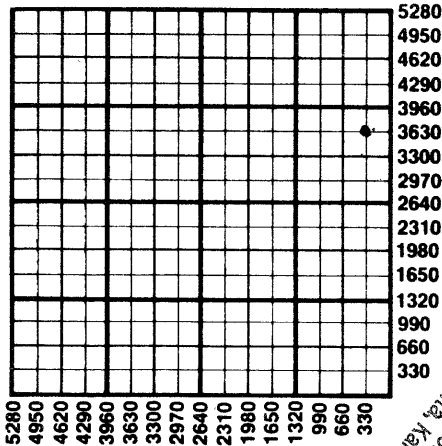

8-30-85

RECEIVED
 AUG 30 1985
 STATE CORPORATION COMMISSION
 CONSERVATION DIVISION
 WICHITA, KANSAS

State Corporation Commission of Kansas
 Conservation Division
 200 Colorado Derby Building
 Wichita, Kansas 67202
 (316) 263-3238